

MINUTES
PLANNING COMMISSION REGULAR MEETING
G.L. Gilleland Council Chambers on 2nd Floor
Monday, August 14, 2023

- 1. CALL TO ORDER:** Chairperson Randy Davis called the meeting to order at 5:30 p.m.
- 2. ROLL CALL:** Present were Planning Commission Members, Sandy Sawyer, Alexis Noggle, Anna Tobolski, City Attorney Kevin Tallant, Councilmember Liaison Caleb Phillips, Councilmember John Walden, City Manager Bob Bolz, Planning Director Jameson Kinley, Zoning Administrative Assistant Stacy Harris, Building Inspector Clay Moss. Josh Nichols was absent from the meeting.
- 3. INVOCATION AND PLEDGE:** City Manager Bob Bolz led the invocation and pledge.
- 4. ANNOUNCEMENTS:** None
- 5. APPROVAL OF THE AGENDA:** Motion to approve the agenda made by A. Noggle; second by A. Tobolski. Vote carried unanimously in favor.
- 6. APPROVAL OF THE MINUTES:** Motion to approve the regular meeting minutes held on Monday, July 10, 2023, made by S. Sawyer; second by A. Noggle. Vote carried unanimously in favor.

PUBLIC HEARING

- 7. ZSP C230063:** Atlanta Motorsports Park, LLC has petitioned to amend the current site plan and current stipulations; located at 20 Duck Thurmond Road (TMP 070 049 001). Public Hearing Dates: Planning Commission on Monday, August 14, 2023, and City Council on Monday, August 21, 2023. City Council for a decision on September 18, 2023.

Chairperson Davis read the zoning site plan request and conducted the public hearing. Motion to open the public hearing made by A. Tobolski; second by A. Noggle. Vote carried unanimously in favor.

Planning Director J. Kinley provided the staff analysis report with the request to amend the site plan and the current stipulations.

The following person spoke in favor of the zoning request:

- Joey Homans, 272 Hwy 9 South, Dawsonville, GA, – Mr. Homans stated that he is representing Atlanta Motorsports Park / Jeremy Porter and he wanted to first adopt and incorporate by reference the presentation that Atlanta Motorsports Park presented at the June 12, 2023. Planning Commission meeting in the interest of time. Mr. Homans stated he and his client listened to the public comments and met with staff to discuss the items brought forth. He stated that his client submitted a Development Regional Impact (DRI) application and an amended letter of intent. Mr. Homans stated he is requesting the following modifications in the recommendations for conditions of approval:
 - i. Condition # 20, the site plan date is incorrect, and the corrected date is May 30, 2023
 - ii. Condition # 17, sound limits being approved from 98 DBA to 101 DBA and from 63 DBA to 65 DBA and a request for the opportunity for the City Council to vote to reduce those back at some point in the future. His client will agree to that if he is entitled to a hearing about why the sound needs to be reduced to that and have that opportunity to come address that before City Council.
 - iii. The site plan serves as a purpose for the Atlanta Motorsports Park, from the cottages, condos, and lighting of the Go-Kart Track.

MINUTES
PLANNING COMMISSION REGULAR MEETING
G.L. Gilleland Council Chambers on 2nd Floor
Monday, August 14, 2023

In closing, Mr. Homan and AMP asked the Planning Commission members to approve these conditions with the modifications requested.

- Jeremy Porter, 20 Duck Thurmond Rd, Dawsonville, GA – Mr. Porter stated that after he spoke with some of the Planning Commission members, he went back and modified what he could, based on their feedback. These modifications included:
 - i. hours of the Go-Kart Track limited to GA Dept of Labor rules
 - ii. change the LED billboard sign to a regular sign
 - iii. (4) four open sound limit race weekends, he agreed to (2) two open sound limit race weekends
 - iv. change the covenants on the rental of the cottages/condos to 25%
 - v. increase sound limits from 98 to 101 DBA track level and 63 to 65 DBA property line and if the increased sound does not work with the community/city, then take it back to the original sound limits of 98 DBA track level and 63 DBA property line.

Mr. Porter asked that the Planning Commission members consider 13 years of actions in this business of the Atlanta Motorsports Park's impact on the community. He stated that they are one of the largest employers in the city and have multiple businesses underneath the City. The taxable revenue on the condos does not tax the fire and ambulance department. He stated that they maintain their own water and sewer department and paved their own roadways.

The following person spoke in opposition of the request:

- Karl Stalnaker, 135 Duck Thurmond Rd, Dawsonville, GA 30534 – Mr. Stalnaker had questions regarding the placement and material of the sign and why there was not any further investigation into bringing a sound expert to give more information. He also asked, had there been any thought about other access to the racetrack other than off of Duck Thurmond Road.
- Richard Wingate, 683 Duck Thurmond Rd, Dawsonville, GA 30534 – Mr. Wingate stated that he was here on behalf of Dr. Wes and Helen Hamryka. He stated that the Hamryka's are not absolutely opposed to these modifications, but they do have concerns and would like those concerns addressed and on the record. As to what is proposed, they are not against the additional lighting if it meets code. The ability to conduct noiseless events on the track during off-peak hours for military and police purposes is thoroughly undefined. Needs to be addressed. They were fully against the two (2) race weekends with unlimited sound levels. The adding of elevated parking decks that are visible from the outside seems to be out of harmony with the community and they are against. As to the PA system and the increase sound levels at the track and at the buffers, they are absolutely opposed to.
- Renee Duren, 2602 Sweetwater Juno Rd, Dawsonville, GA – Ms. Duren stated concerns around the extended hours for go-karts and the proposed update to stipulation 1(i). She believed this was part of a plan to operate a restaurant, brewery, and distillery. Mr. Porter was interviewed by Biz Now, following the DRI process. In that article dated July 10, 2023, Mr. Porter announced plans that included a restaurant, brewery, and distillery, as well as an underground shooting range at AMP. Ms. Duren also stated that an application to register a business under Fuel Kitchen was listed in the legal section on Dawson News. Under the existing stipulation 15, it restricts hours of on-track activity as well as operation

MINUTES
PLANNING COMMISSION REGULAR MEETING
G.L. Gilleland Council Chambers on 2nd Floor
Monday, August 14, 2023

in general. With that, brings the updated proposed stipulation 1(i), which grants approval of changes and principal use without the City Council. Restaurants, breweries, and distilleries are not permitted uses in zoning CIR currently and is not included in this list of requests. Also, an article in Smoke Signals from Big Canoe stated that it will open this month. She stated that she spoke with the health department today and the construction permit has already been applied for. Her concern was when you cut out City Council, you cut out public hearings, and a principal use is something that she believed should be decided by City Council.

- Tom Victor, 48 Victor Drive, Dawsonville, GA – Mr. Victor stated that he lives one mile and three tenths from the racetrack, and he would like to play a video that he made on his back porch when AMP had a special event. Chairperson Davis asked City Attorney K. Tallant if that was allowed. City Attorney K. Tallant said it was allowed. Mr. Victor played the video. In the video you could hear what appears to be car sounds. Mr. Victor stated that this goes on all day long and they take short breaks. This is a nuisance.
- Doris Adams, 440 High Hope Farm Road, Dawsonville, GA – Ms. Adams stated she lives approximately three miles from the racetrack. She stated that the sound does not stay contained inside of the racetrack and it jumps over the barriers. Ms. Adams also asked the question “Where is the wildlife”.

Motion to extend the public hearing by 10 minutes was made by A. Tobolski; second by A. Noggle. Vote carried unanimously in favor.

- Natosha Beary, 2555 Sweetwater Juno Road, Dawsonville, GA – Ms. Beary stated that she called Councilmember Phillips and discussed with him that noise before 8:00 a.m. According to Councilmember Phillips, there were 14 violations that day. She further stated that the AMP is technically annexed into the city. The impact of surrounding properties is not in the city, and they didn't have a voice. Mr. Porter states that he is wanting to be a good neighbor and limitless sounds in her opinion was not being a good neighbor.
- Claire Meyer, 2681 Sweetwater Juno Road, Dawsonville, GA – Ms. Meyer stated she is concerned about the noise and traffic. She stated that the noise levels will impair their child's health and the possibly of people drinking and driving leaving this establishment.
- Brian Duran, 2681 Sweetwater Juno Road, Dawsonville, GA – Mr. Duran stated he is concerned about the traffic, sound, and light pollution. He stated that he is a geospatial engineer and would like to publicly extend his help with the cartography. Sound is not linear, so it goes in all directions much like light does and it is very three-dimensional. When a fence is placed, it does help with the sound but because the sound is not linear, it does extend and go out. Mr. Duran stated that he could make a sound map of the intrusive amounts of decibels around the property and maybe that would be a comfort to the problem. He stated that people do not understand what the decibels are and how much is intrusive and damaging to the ear. Surprisingly small amounts of noise damages hearing permanently.

Mr. Homans addressed the questions that were asked during the public notice. Mr. Homans stated that the sign would be placed on the bottom corner of the property facing Highway 53 West. They will provide the City Manager at his request with notice of the military and law enforcement training.

MINUTES
PLANNING COMMISSION REGULAR MEETING
G.L. Gilleland Council Chambers on 2nd Floor
Monday, August 14, 2023

The parking decks are going to be single story. Mr. Homans stated that regarding the sound levels, his client would like to come to a national standard that was provided during the last Planning Commission Meeting on Monday, July 10th and if it does not work, they are willing to come back and address the sounds and special events. Mr. Homans stated that as far as the restaurant is concerned, that had been approved and been on the site plan and Mr. Porter will provide you with more information.

Mr. Porter addressed the questions and concerns, where is the wildlife? – it's on the racetrack. The go-kart kitchen planned was approved. A restaurant is not unfounded, they have gone through the proper permitting process. The Planning Director brought it up for clarity's sake, as well as the track extension was approved in 2009. The track was moved back because of streams and wetlands and to save time, money, and stream credits, they moved the track back. Mr. Porter stated that for the past eleven years they have been having 200 plus car events so this will not be any different in traffic. The PA system that they were asking to use is on the existing speakers that has been in place for the past eleven years. The OSHA, World Health Organization, and ANSI have a limitation for nuisances and that's why they put 65 decibels at the property line. The sign at Highway 53 West would fall underneath the regulations of the city code. Mr. Porter further stated that he asked for 103 because that's what most racetrack limits are. They moved the sounds limits down from 103 – 101 decibels, a streetcar (Corvette, Porsche, Lamborghini) driving straight from the dealership, the DOT approves to be in your neighborhoods, city street, and highway. These types of vehicles cannot drive on the track and that's why they are asking for an increase in sound.

Motion to close the public hearing made by A Noggle; second by A. Tobolski. Vote carried unanimously in favor.

After a fervent discussion among the Commissioner Members, Planning Director J. Kinley, Mr. Porter, Mr. Homans and City Attorney K. Tallant regarding the track extension, sound limits, two unlimited sound race weekends, go-kart extended hours, kitchen/restaurant, condos and road improvements, a motion to recommend approval of ZSP-C2300063, the amended site plan and stipulations represented in the attached "Exhibit A" was made by A. Tobolski; second A. Noggle. Vote carried unanimously in favor.

BUSINESS

8. Silver Leaf Townhomes/Livic Properties, LLC As Built / Final Plat:

Planning Director J. Kinley provided the staff analysis report with the request to as built / final plat.

Motion to recommend approval of the as built / final plat represented in the attached "Exhibit B" made by A. Tobolski; second A. Noggle. Vote carried unanimously in favor.

PLANNING COMMISSION REPORTS: Next Planning Commission Meeting is Monday, September 11, 2023.

ADJOURNMENT: Motion to adjourn the meeting at 7:38 p.m. made by S. Sawyer; second by A. Tobolski. Vote carried unanimously in favor.

MINUTES
PLANNING COMMISSION REGULAR MEETING
G.L. Gilleland Council Chambers on 2nd Floor
Monday, August 14, 2023

Approved this 9th day of October 2023



Randy Davis, Commission Chairperson



Alexis Noggle, Planning Commissioner Post 1


Josh Nichols, Planning Commissioner Post 2
Sandy Sawyer, Planning Commissioner Post 3
ABSENT

Anna Tobolski, Planning Commissioner Post 4

Attested: Clay N.

Stacy Harris, Zoning Administrative Assistant

Clay Moss

Planning Commission recommended approval of the amended site plan and the following stipulations:

1. Private driving instruction and exhibition facility shall mean a facility containing a paved roadway two or more miles in length (the "driving course") the use of which is limited to:
 - a) Providing instruction and training in safe driving skills, adverse weather driving techniques, or high performance/competition driving
 - b) The exhibition, maintenance, and operation of vintage or specialty motor vehicles
 - c) Similar activities which are recreational or educational in nature
 - d) A private driving instruction, racing and exhibition facility
 - e) Accessory clubhouse, rental garages, retail and permitted commercial or industrial uses serving the primary driving course operations
 - f) Garage Condos (Approved September 9, 2019)
 - g) 46 Race Cottages
 - h) Ability to allow up to 25% of owners to rent Airbnb, VRBO, etc. condos and race cottages
2. The Applicant/Owner, their successors and assigns by application for and acceptance of this rezoning shall have conclusively deemed to have agreed to indemnify the City and its agents and representatives from all liability including personal injuries and property damage coming out of the extensive, use, ownership, or operation of the Motorsports Park.
3. When the driving course is not in use, it shall be secured in such a manner to prevent its unauthorized use.
4. Any Public Address (PA) system shall be below 90 DBA at 50 feet from the speaker.
5. The driving course shall be enclosed by a fence of a height and construction sufficient to preclude unauthorized persons from gaining access to the driving course from the main entrance, hot and cold pit areas.
6. When the car/motorcycle driving course is in use at speeds more than 45 mph, the operator shall, at his/her expense, onsite, a fully equipped ambulance with EMT. The EMT's shall be licensed under the laws of the State of Georgia.
7. Rental garages, Club House, rental buildings, and any other permitted commercial/industrial building shall be placed strategically to reduce sound levels. The location of the buildings shall be approved by the City Planning Director.
8. There shall be fifty (50) foot or greater undisturbed buffers along all streams.
9. Where the property runs along Duck Thurmond Road, buildings and existing Acoustiblok or similar quality sound fence shall be placed to reduce the sound levels and keep as much vegetative cover as possible on the approved site plan.
10. There shall be a buffer of between one hundred (100) feet and two hundred (200) feet to reduce sound levels as designed by Owner's sound engineer to meet the requirements of Condition 17. The buffer shall be around the perimeter of the property and shall be undisturbed except to permit an entrance road to the subject property, the construction of sound mitigation measures and/or the installation of any utilities. This buffer shall be planted

EXHIBIT "A"

in any area that is not visually impervious to a level approved by the City Planning Director in order to prevent any soil erosion.

11. Exterior lighting fixtures shall be of the box type and situated so that light only goes downward and shall not be more than twenty-five feet high and shall be designed so to minimize glare and light spillage to not more than one (1) foot candle along the interior buffer line of the subject property. With the exception of the kart lighting outlined in condition 14b.
12. There will be no grandstand(s) constructed on the property.
13. All signs at property lines will meet current regulations. Atlanta Motorsports Park will be allowed two signs on the property. The existing Atlanta Motorsports Park sign is approved and placed at the entrance on Duck Thurmond Road. The second sign will be allowed on highway 53 on the berm of the retention pond. The second sign will be two sided and follow the current sign and size regulations allowed under the CIR designation.
14. Hours of operation are limited to 7:00 a.m. to 6:00 p.m. from November 1 to March 31. From April 1 to October 31, the hours are limited to 7:00 a.m. (or one (1) hour after sunrise, whichever is earlier) to 8:00 p.m. (or one (1) hour after sunset, whichever is earlier). No on track activity before 8 a.m.
 - a) Go-Kart Track extended to 9:00 p.m. Monday through Thursday, 11:00 p.m. Friday and Saturday, and 8:00 p.m. on Sunday, seasonal April 1st through October 31st.
 - b) The lighting for the go-kart track is LED only, and be a similar system/brand design, light spill, pole height, etc. as the MUSCO Lighting System Kart Spill Lighting Plan Date Oct 7th, 2022, and Kart Lighting Design and Details dated August 16, 2022.
 - c) Military and Law Enforcement training and events are allowed after hours without noise with a 45-day notice to the City Manager.
15. No type of vehicle other than maintenance vehicles, military or law enforcement may run on the track before or after the hours listed above.
16. Facility to be restricted to site plan as submitted as to the use of the property, the type of structures allowed and the general placement of the structure as the same may be revised by the Owner's sound engineer to meet the sound requirements of Condition 17. Any major adjustments, change or additions must be approved by the Planning Commission. Any minor adjustments must be approved by the Planning Director. The decision of what is major, or minor is to be made at the discretion of the Planning Director.
17. Sound monitoring meters shall be installed in four locations around the perimeter of the property at the property line on the outside edge of the buffer at locations as shown on the approved site plan. These meters monitor in a unified fashion, if multiple meters read above the sound limits at the same time and same day, it does not result in multiple fines, but one fine per incident. If one meter reads above the sound limit and the others do not, it does result in a fine. In addition, the Owner shall install one sound meter 50 feet from the outside track pavement edge to monitor track sound levels such that they remain below 98 DBA LEQ per vehicle at all times. Only Low Noise Go-Karts may be operated on the track and their noise level may not exceed 92 DBA LEQ. The Owner, its successors and assigns shall operate the sound monitoring meters at all times that the track is operating. As a condition of continued operation pursuant to their business license, sound levels at the four locations outside the existing sound fence as depicted on the approved site plan shall not exceed 63 DBA LEQ (16).

EXHIBIT "A"

Method of measurement: Measurements shall be made with a calibrated sound level meter in good condition, meeting the requirements of a Type 1 or Type 2 meter, as specified in ANSI Standards, section 1.4 – 1971. For the purpose of this section, a sound level, a sound level meter shall contain at least an “A” weighting network, and both fast and slow response capability. Failure to comply with this condition shall result in a citation for watch offense and upon conviction a fine as set by the City Judge of up to \$1,000 per violation. Upon three or more convictions for failure to comply with this condition during any calendar year, the Mayor and Council may revoke the business license and the ability of Owner, and its successors and assigns to operate the facility as a motorsports park complex.

18. All infrastructures shall be designed and installed as required by the Development regulations in force at the time the Owner seeks permits for development.
19. Allow up to two (2) annual events on the car/motorcycle course from Thursday through Sunday that will involve a maximum of 300 racer entrants with open sound limits during events. These events will operate only during the hours of Condition 14 and a minimum 90-day written notice to the adjacent property owners/neighbor. Each event requires prior approval of the City Council. Once approved by the City Council, that event cannot be canceled by any preceding motion.
20. Approval of Master Site Plan page C201 created by Civilogistix dated October 31, 2022, latest revision May 30, 2023.
21. GDOT after they have recommended their improvements, that these be reviewed by the City Council with the potential petitioner, paying for the improvements at Highway 53 West and Duck Thurmond Road, with any further expansion of Atlanta Motorsports Park.



CIVIL LOGISTIX
S00 SU VALLEY DRIVE STE H3
DAWSONVILLE, GA 30078
(404) 591-4403 - CIVILLOGISTIX.COM

COVER SHEET
AMP FUTURE IMPROVEMENTS
20 DUCK THURMOND RD, DAWSONVILLE, GA 30078

C001
21320
OCTOBER 31, 2022
Revisions _____

AMP FUTURE IMPROVEMENTS

SITE PLANS FOR:

20 DUCK THURMOND RD
DAWSONVILLE, GA 30534
LAND LOTS 254, 255, 291, 292, & 323 - DISTRICT 4

OWNER/DEVELOPER:

ATLANTA MOTORSPORTS PARK


ADDRESSES FOR INDIVIDUAL
STRUCTURES TO BE ASSIGNED BY
DAWSON COUNTY

1. AS-BUILT SITE CONDITIONS WILL BE REQUIRED AND RECORDED PRIOR TO ISSUANCE OF CERTIFICATE OF OCCUPANCY
2. ALL UNDISTURBED BUFFERS SHALL BE IDENTIFIED WITH ORANGE, FOUR-FOOT TREE-SAVE FENCING, PRIOR TO ANY LAND DISTURBANCE.

24 HOUR CONTACT

JEREMY PORTER
(404)933-3436
ATLANTA MOTORSPORTS PARK
20 DUCK THURMOND ROAD
DAWSONVILLE, GA 30534

NOTE: DAWSONVILLE INSPECTOR: 24 HOURS
BEFORE BEGINNING PHASE OF CONSTRUCTION. (404) 242-2525.

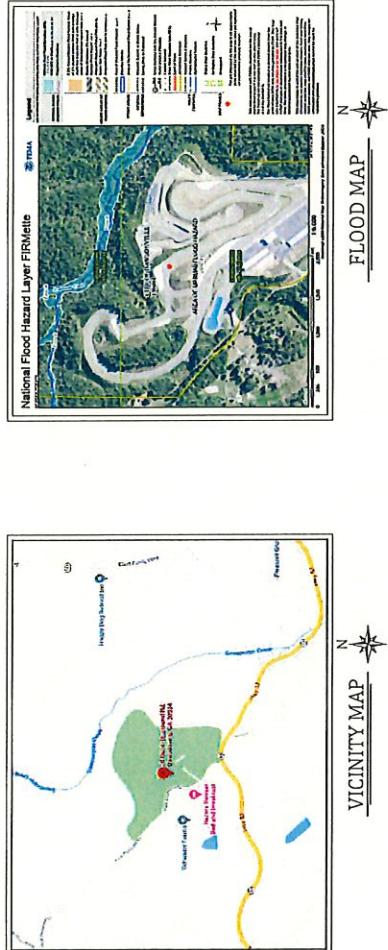

CIVIL
C001
COVER SHEET
C002
ZONING CONDITIONS
C003
MASTER SITE PLAN
C004
TRACK EXT
C005
TURN 15 MODIFICATION
C006
PHASE 4 CONDOS
C007
PHASE 5 CONDOS
C008
PHASE 6 CONDOS
C009
PHASE 7 CONDOS
C010
GO-KART GARAGES
C011
CAROUSEL BUILDINGS
C012
TURN 6 BUILDINGS
C013
ELEVATED GO-KART CONDOS
C014
ELEVATED PIT LANE CONDOS
C015
ELEVATED PIT LANE CONDOS
C016
GOLF CART PATH
C017
GOLF CART PATH
C018
GOLF CART PATH
C019
GOLF CART PATH

C001
21320
OCTOBER 31, 2022
Revisions _____

DATE: OCTOBER 31, 2022
REVISED: FEBRUARY 9, 2023
REVISED: APRIL 27, 2023
REVISED: MAY 30, 2023

EXHIBIT "A"




C201


21320

OCTOBER 31, 2022

REVISIONS

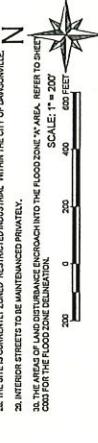


N

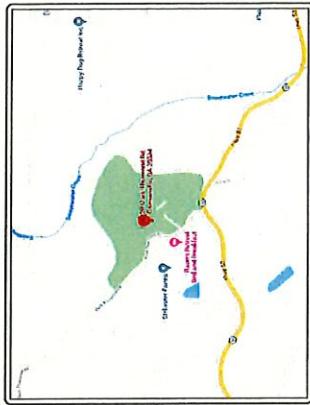

GENERAL NOTES

- ALL WORK AND MATERIALS SHALL COMPLY WITH THE CITY OF DAWSONVILLE, STATE OF GA, REGULATIONS AND CODES, AS WELL AS FEDERAL, STATE, AND LOCAL REQUIREMENTS.
- STEREOPHOTOGRAPHY, UTILITY AND ROAD INFORMATION TAKEN FROM A SURVEY BY GRANT SHIPERD, ASSOCIATES, ADDRESS P.O. BOX 15, 1015 1/2 1/2 ST., LAWRENCEVILLE, GA 30044. ON 10/10/2015, REVISIONS 15, 03-03-15.
- ACCORDING TO INITIAL DEVELOPMENT SURVEY PREPARED BY GRANT SHIPERD & ASSOCIATES, INC. ON 10/10/2015, THIS SURVEY IS BASED ON THE SURVEY OF THE SURVEYOR OF THE STATE OF GEORGIA FOR THE CITY OF DAWSONVILLE, WHICH IS BASED IN CONFORMITY WITH THE 1973 STATE PLANE COORDINATE SYSTEM.
- BUILDING DIMENSIONS SHOWN ON THIS PLAN ARE LEASER DIMENSIONS. FOR ACTUAL DIMENSIONS, SEE ARCHITECTURAL PLANS. DIMENSIONS TO CONC CURB CUTTER AREA TO FACE OF CURB.
- CIVIL CONTRACTOR IS RESPONSIBLE FOR WORK TO WITHIN 5' OF THE BUILDING.
- EXISTING STRUCTURES AT THE CONSTRUCTION LIMITS ARE TO BE ABANDONED, REMOVED, OR RELOCATED AS INDICATED ON THE PLANS AND IN THE SPECIFICATIONS.
- CONTRACTOR IS TO NOTIFY CITY INSPECTORS 72 HOURS PRIOR TO THE START OF CONSTRUCTION.
- CONTRACTOR SHALL OBTAIN AN EASEMENT BEFORE CONSTRUCTION BEGINS, INCLUDING ON PROPERTY OWNED BY THE CITY OF DAWSONVILLE, EATING ORDINANCE.
- ALL CONCRETE TRAILERS MUST BE REMOVED FROM THE SITE BY THE CONTRACTOR.
- CONSTRUCTION TRAILERS LOCATED ON THE SITE MAY BE REMOVED BY THE CONTRACTOR.
- CONTRACTOR SHALL NOT PARK CONSTRUCTION EQUIPMENT IN REAR OF BUILDINGS AND AREA WHICH RESTRICT SIGHT DISTANCE.
- THE EXACT LOCATION OF HANDICAP RAMPS SHALL BE COORDINATED WITH THE ARCHITECTURAL DRAWINGS AND SHALL BE PROVIDED AT THE INTERSECTIONS OF EACH APPLICABLE SIDEWALK AND ENTRANCE DRIVES.
- ALL SIDEWALK AREAS ARE TO BE INSTALLED PER ADA STANDARDS. SIDEWALKS TO HAVE MAX. SLOPE OF 1% AND MAX CROSS SLOPE OF 1/4%.
- CONTRACTOR SHALL NOTIFY ENGINEERS SHOULD ANY FIELD CONDITIONS BE NOTED THAT DIFFER FROM THE SURVEY.
- SITE CONTRACTOR SHALL JURISDICTION ALL CHANGES AND VARYING DRAFT BUILDING LOCATION, DRAWDOWNS, ATTACHMENT POINTS, DRIVeways, ETC.
- PROJECT LOCATION: 20 DUCK THRESHOLD RD CORNER OF HWY 23 AND DUCK THRESHOLD ROAD, IN THE CITY OF DAWSONVILLE, GWINNETT COUNTY, STATE OF GEORGIA, 30054. PHONE NUMBER: (404) 363-2200. CONTACT: BRENT PORTER.
- OWNER INFORMATION: BRENT PORTER, 20 DUCK THRESHOLD RD, DAWSONVILLE, GA 30054. PHONE NUMBER: (404) 363-2200. CONTACT: BRENT PORTER.
- ENGINEER: CIVILLOGIX, LLC, 160 SUN VALLEY DRIVE, ROSWELL, GA 30076. PHONE NUMBER: (404) 591-4403. CONTACT: DAVID WHITE, CIVILLOGIX.COM.
- BUILDING LOCATION IS TO THE OUTSIDE FACE OF BLOCK. CONTRACTOR TO COORDINATE AND VERIFY DRAFT BUILDING LOCATION, DRAWDOWNS, ATTACHMENT POINTS, DRIVeways, ETC.
- IRRIGATION SYSTEMS ARE PROVIDED ON ALL EXISTING AND PROPOSED CITY HIGHWAY AND SIDEWALKS. CONTRACTOR IS TO CONNECT THESE SYSTEMS TO THE CITY SYSTEMS AS PROVIDED IN THE CONTRACT DOCUMENTS.
- NO CONSTRUCTION OR WORK IS ALLOWED ON ANY PUBLIC PROPERTY, WHETHER IT BE A CITY STREET, PARK, PARKING LOT, OR OTHER PROPERTY OWNED BY THE CITY OF DAWSONVILLE.
- NO OVERNIGHT PARKING IS ALLOWED OUTSIDE OF BUILDINGS.
- WORK HOURS SHALL BE REVERSED THE DATES OF 7/24 AND 8/22, MONDAY-FRIDAY AND SUNDAY.
- THE SITE ENCROACHES IN PART OF FLOOD ZONE C, BASED ON MAP NUMBER 130200 EFFECTIVE ON 10/1/2022.
- THE SITE IS CURRENTLY ZONED RESTRICTED INDUSTRIAL* WITHIN THE CITY OF DAWSONVILLE.
- INTERIOR STREETS TO BE MAINTAINED PRIVATELY.
- THE AREA OF LAND SURFACE ENCROACHED INTO THE FLOOD ZONE C AREA, REFER TO SHEET C201 FOR THE FLOOD ZONE RESTRICTIONS.

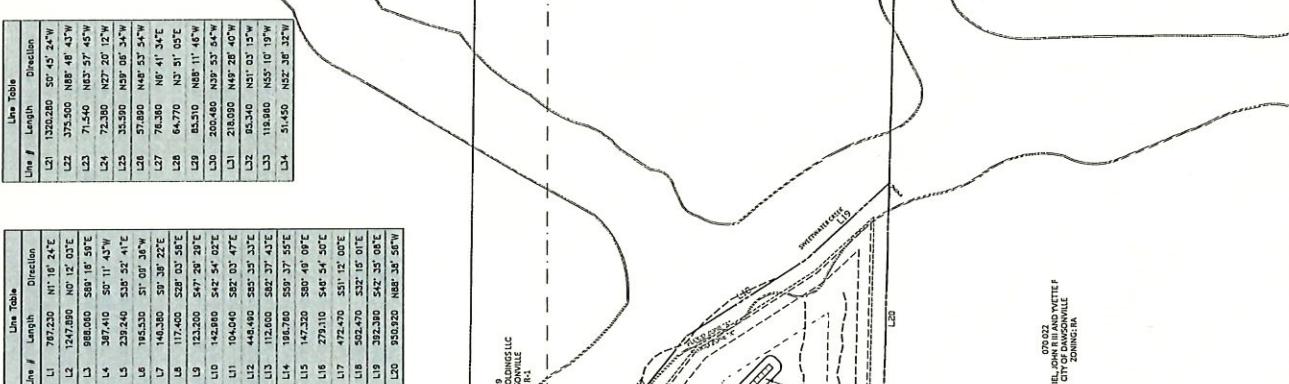

Curve Table			
Line #	Length	Delta	Chord Bearing
L1	297.230	N1° 16' 21" W	
L2	1320.280	S0° 45' 24" W	
L3	127.500	N85° 48' 43" W	
L4	27.540	N85° 57' 45" W	
L5	988.080	S89° 16' 59" W	
L6	397.410	S2° 11' 43" W	
L7	227.330	N27° 20' 12" W	
L8	25.930	N89° 54" W	
L9	27.930	N85° 57' 54" W	
L10	195.530	S1° 06' 36" W	
L11	148.380	S9° 38' 22" E	
L12	64.770	N2° 51' 55" E	
L13	85.310	N85° 11' 45" W	
L14	142.880	S42° 54" 50" E	
L15	200.480	S29° 20' 45" W	
L16	110.040	S82° 03' 47" E	
L17	120.490	S32° 15' 57" E	
L18	145.490	S85° 35' 57" E	
L19	172.600	S62° 37' 47" E	
L20	118.860	N52° 10' 19" W	
L21	51.150	N85° 37' 55" W	
L22	147.220	S80° 49' 00" E	
L23	229.210	S45° 54' 50" E	
L24	172.470	S51° 12' 00" E	
L25	202.470	S32° 15' 57" E	
L26	230.800	N62° 35' 57" W	

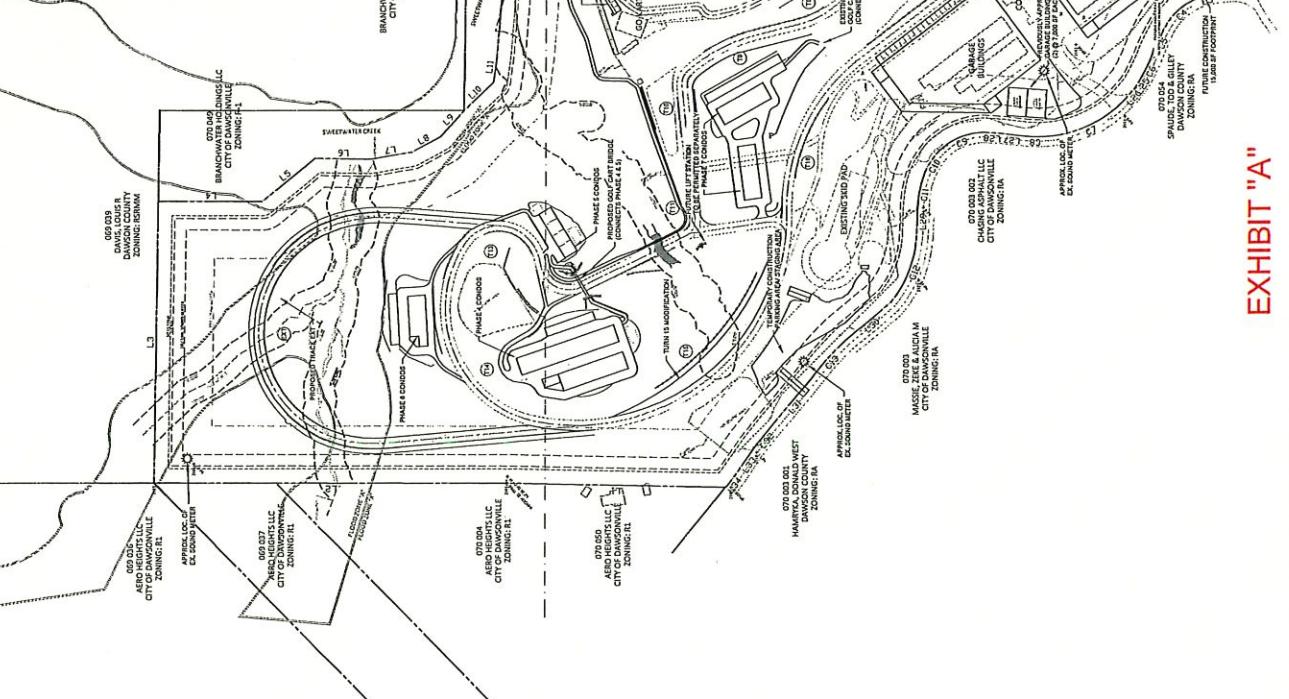


EXHIBIT "A"

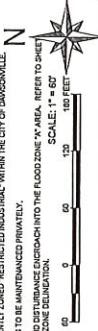



EXHIBIT "A"

BRANCHWATER HOLDINGS LLC
CITY OF DAWSONVILLE
ZONING: R-1

LIGHTING NOTES

1. SITE LIGHTING NOT INCLUDED IN PLAT SET.
2. SITE LIGHTING TO BE DESIGNED BY OWNER.

SWEETWATER CREEK

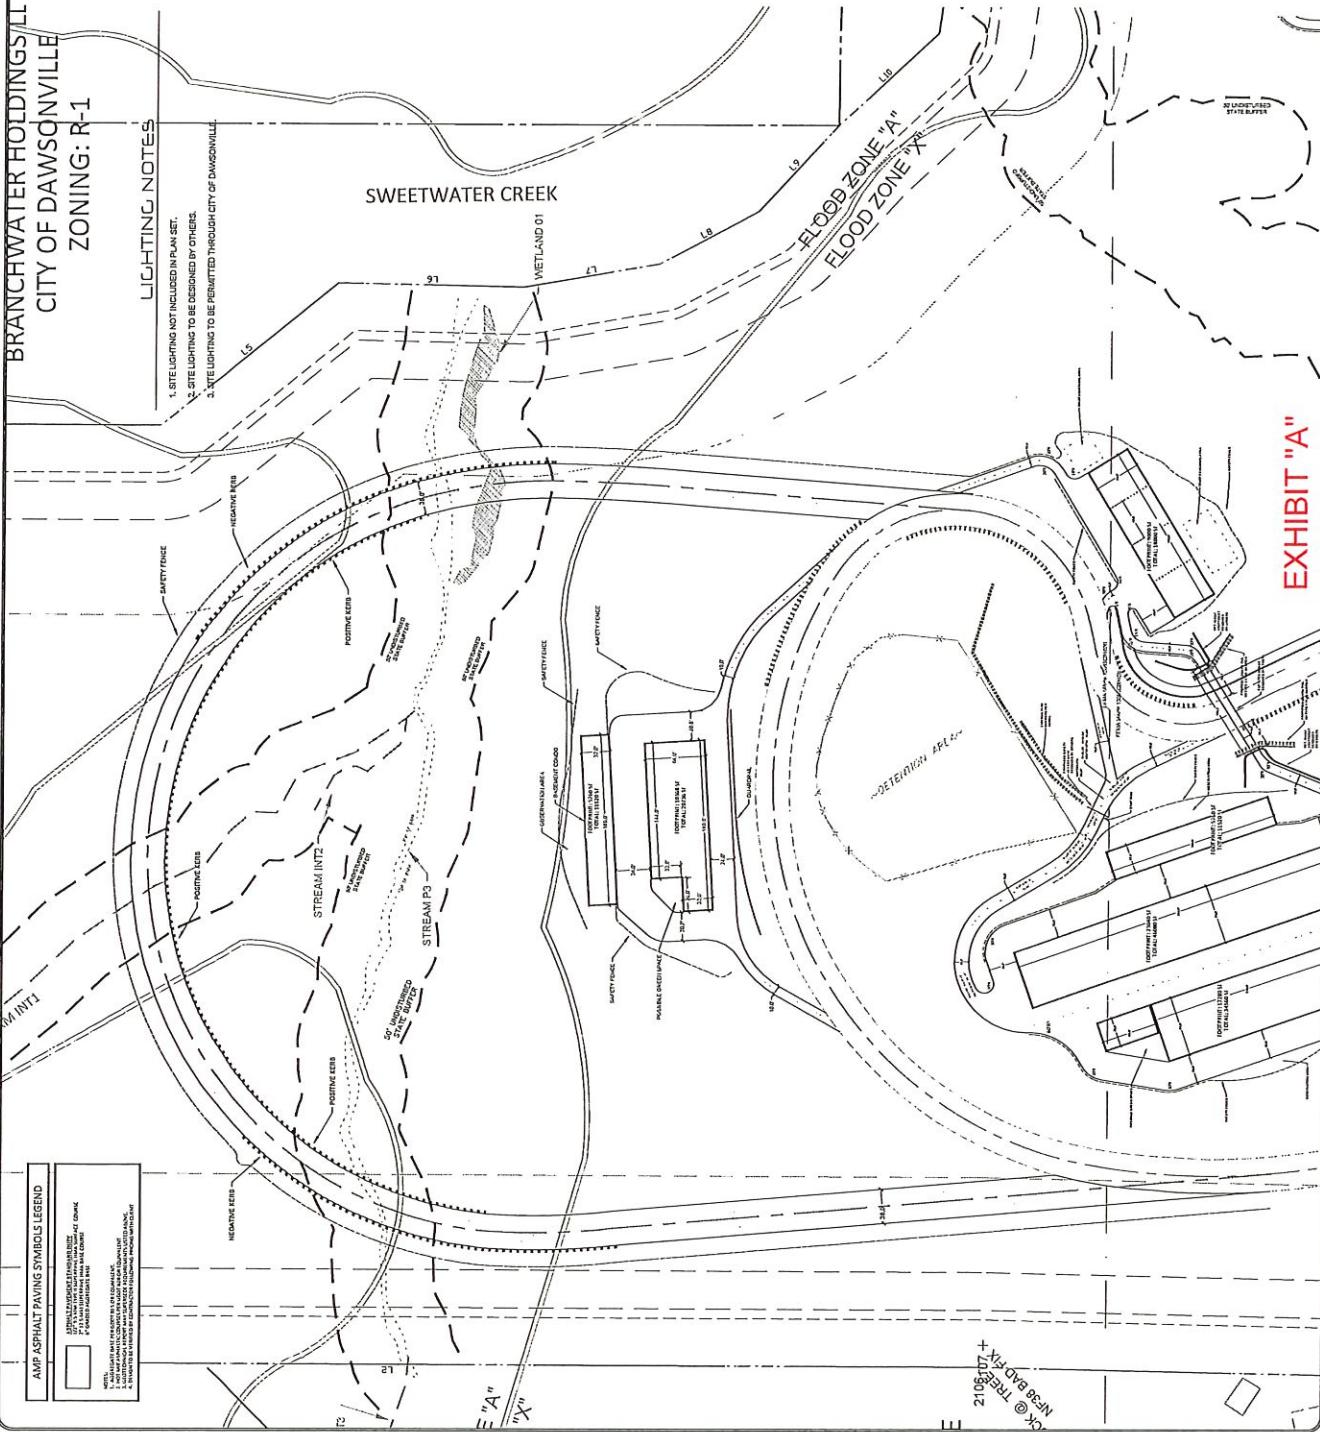




CIVIL OLETSIX


SITE PLAN: TURN 15
AMP FUTURE IMPROVEMENTS
DAWSONVILLE, GA 30076

RECEIVED
DRAFTING
05-23-23

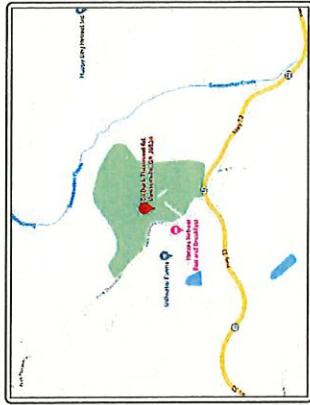

GENERAL NOTES

- ALL WORK AND MATERIALS SHALL COMPLY WITH THE CITY OF DAWSONVILLE, STATE OF GA REGULATIONS AND CODES, AS WELL AS ALL GSA STANDARDS.
- STREET BOUNDARY, TOPOGRAPHY, UTILITY AND ROAD INFORMATION TAKEN FROM A SURVEY BY GRANT SHEPHERD & ASSOCIATES, ADDRESS 75 LONGLEY BLVD., SUITE A, LAWRENCEVILLE, GA 30046, DATED 02-25-15, (REVISED 03-15-15) D-05-177.
- ACCORDING TO INITIAL DEVELOPMENT SURVEY PREPARED BY GRANT SHEPHERD & ASSOCIATES, ADDRESS 75 LONGLEY BLVD., SUITE A, LAWRENCEVILLE, GA 30046, DATED 02-25-15, (REVISED 03-15-15) D-05-177, THE SUBJECT PROPERTY IS LOCATED IN THE 100 YEAR FLOOD ZONE.
- BUILDING DIMENSIONS SHOWN ON THIS PLAN ARE "CLEAR" DIMENSIONS. FOR ACTUAL DIMENSIONS, SEE ARCHITECTURAL PLANS.
- STRUCTURE CONTRACTOR IS RESPONSIBLE FOR WORK TO WITHIN 2'-0" OF THE BUILDING.
- CONSTRUCTION STRUCTURES AND CONSTRUCTION MATERIALS NOT BE LAUNCHED, REMOVED OR RELOCATED AS INDICATED ON THE PLANS AND IN THE SPECIFICATIONS.
- CONTRACTOR TO NOTIFY CITY INSPECTOR 72 HOURS PRIOR TO THE START OF CONSTRUCTION.
- CONTRACTOR SHALL CEASE ALL WORK BEFORE CONSTRUCTION BEGINS, INCLUDING ON DUTY DAY/NIGHT/EMERGENCY PERIOD.
- ALL SIGNS SHALL CONSIST WITH THE CITY OF DAWSONVILLE ZONING ORDINANCE. A SEPARATE SIGN PERMIT IS REQUIRED.
- CONSTRUCTION TRADES ON SITE CONSTRUCTION SITE SHALL BE PERMITTED THROUGH THE CITY OF DAWSONVILLE PLANNING AND ZONING DEPARTMENT.
- CONSTRUCTION EQUIPMENT SHALL NOT BE PARKED IN DESIGNATED PROPERTY OWNED AND MAINTAINED BY THE CITY OF DAWSONVILLE. CONSTRUCTION EQUIPMENT SHALL NOT BE PARKED IN AREA WHICH RESTRICTS SIGHT DISTANCE.
- THE EXACT LOCATION OF HANDICAP RAMPS SHALL BE COORDINATED WITH THE ARCHITECTURAL DRAWINGS AND SHALL BE PROVIDED AT THE INTERSECTIONS OF EACH APPROPRIATE SIDEWALK, ACCESS ROUTE, AND ENTRANCE DRIVES.
- ALL SIDEWALKS ARE TO BE INSTALLED PIER STANDARDS. SIDEWALKS TO HAVE MAX. SLOPE OF 5% AND MAX CROSS SLOPE OF 2%.
- CONTRACTOR SHALL NOTIFY BUILDER SHOULD ANY FIELD CONDITIONS BE NOTED THAT DIFFER FROM THE SURVEY.
- STATE CONTRACTOR SHALL FURNISH "AS-BUILT" DRAWINGS INDICATING ALL CHANGES AND DEVIATIONS.
- PROJECT LOCATIONS 20 DUCK THURMING RD CORNER OF HWY 25 AND DUCK THURMING ROAD IN THE CITY OF DAWSONVILLE, DAWSON COUNTY, STATE OF GEORGIA.
- OWNER'S INFORMATION: JEFFERY PORTER, 20 DUCK THURMING RD, DAWSONVILLE, GA 30534, PHONE: 670-354-3907, EMAIL: PORTER.JEFF@GMAIL.COM
- ENGINEER: BULGOGI, LLC, 120 SUGAR VALLEY DRIVE, ROSENWELL, GA 30076, PHONE: 404-584-4040, CONTACT: DAVID WHITE, CHIEF CIVIL ENGINEER
- BUILDING LOCATION IS TO THE OUTSIDE FACE OF BLOCK. CONTRACTOR TO COORDINATE AND VERIFY BUILDING LOCATION IN DAWSONVILLE ARCHITECTURE DIVISION.
- INFORMATION SYSTEMS ARE PROVIDED TO ALL DRAFTER AND PROFESSIONAL DRAFTERS. THE CITY ORGANIZATION PRIMARILY UNIFORMED TO AN INDEX SYSTEM.
- REFINISH WALL DESIGN MUCH BE SUBMITTED TO THE CITY OF DAWSONVILLE FOR APPROVAL PRIOR TO CONSTRUCTION. PLANS MUST INCLUDE WALL DESIGN, COLOR, TEXTURE AND FINISHING. COLOR AND FINISHING MUST BE APPROVED BY THE CITY OF DAWSONVILLE.
- WATER SERVICE TO BE ACCESSED FROM THE CITY OF DAWSONVILLE.
- CITY OF DAWSONVILLE INSPECTOR TO HOURS BEFORE BEGINNING PHASE OF CONSTRUCTION, THUR 25-25-25.
- ALL ZONING DIFFERS SHALL BE IDENTIFIED ON GRD LINE. FENCE SAME FENCING PRIOR TO AND LAND DISTURBANCE.
- RETAINING WALL DESIGN MUCH BE SUBMITTED TO THE CITY OF DAWSONVILLE FOR APPROVAL PRIOR TO CONSTRUCTION. PLANS MUST INCLUDE WALL DESIGN, COLOR, TEXTURE AND FINISHING. COLOR AND FINISHING MUST BE APPROVED BY THE CITY OF DAWSONVILLE. PROFESSIONAL DRAFTER TO PROVIDE A DRAWING OF THE RETAINING WALL, DIRECTED TO THE CITY OF DAWSONVILLE. IN HEIGHT SHALL INCLUDE A 12" DECK OR HANDEL.
- NO OVERNIGHT PARKING TO BE ALLOWED OUTSIDE OF BUILDINGS.
- THE SITE ENDOSES IN THE AREA OF FLOOD HAZARD ON FLOOD ZONE "X". BASED ON MAP NUMBER 130200, EFFECTIVE ON 04/01/18.
- THE SITE IS CURRENTLY ZONED RESTRICTED INDUSTRIAL WITHIN THE CITY OF DAWSONVILLE.
- INTERIOR STREETS TO BE MAINTAINED PRIVATELY.
- THE AREA OF LAND DISTURBANCE ENCLOSED INTO THE FLOOD ZONE "X" AREA, REFER TO SHEET DRAWING 05-23-23.

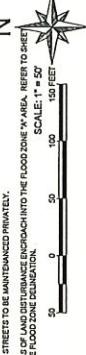

EXISTING SKID]

EXHIBIT "A"

APPROX. LOC. OF
EX. SOUND METER

070 003 001
HAMRYKA, DONALD WEST
DAWSON COUNTY
ZONING: RA


LIGHTING NOTES

- SITE LIGHTING NOT INCLUDED IN PLAN SET.
- SITE LIGHTING TO BE DESIGNED BY OTHERS.
- SITE LIGHTING TO BE REPAINTED THROUGH CITY OF DAWSONVILLE.

HTS LLC : R1
DAWSONVILLE

AMP ASPHALT PAVING SYMBOL LEGEND	
Asphalt Paving	Symbol: Solid black rectangle
Asphalt Paving with White Line	Symbol: White line inside a solid black rectangle
Asphalt Paving with White Dashed Line	Symbol: Dashed white line inside a solid black rectangle
Asphalt Paving with White Dotted Line	Symbol: Dotted white line inside a solid black rectangle

50

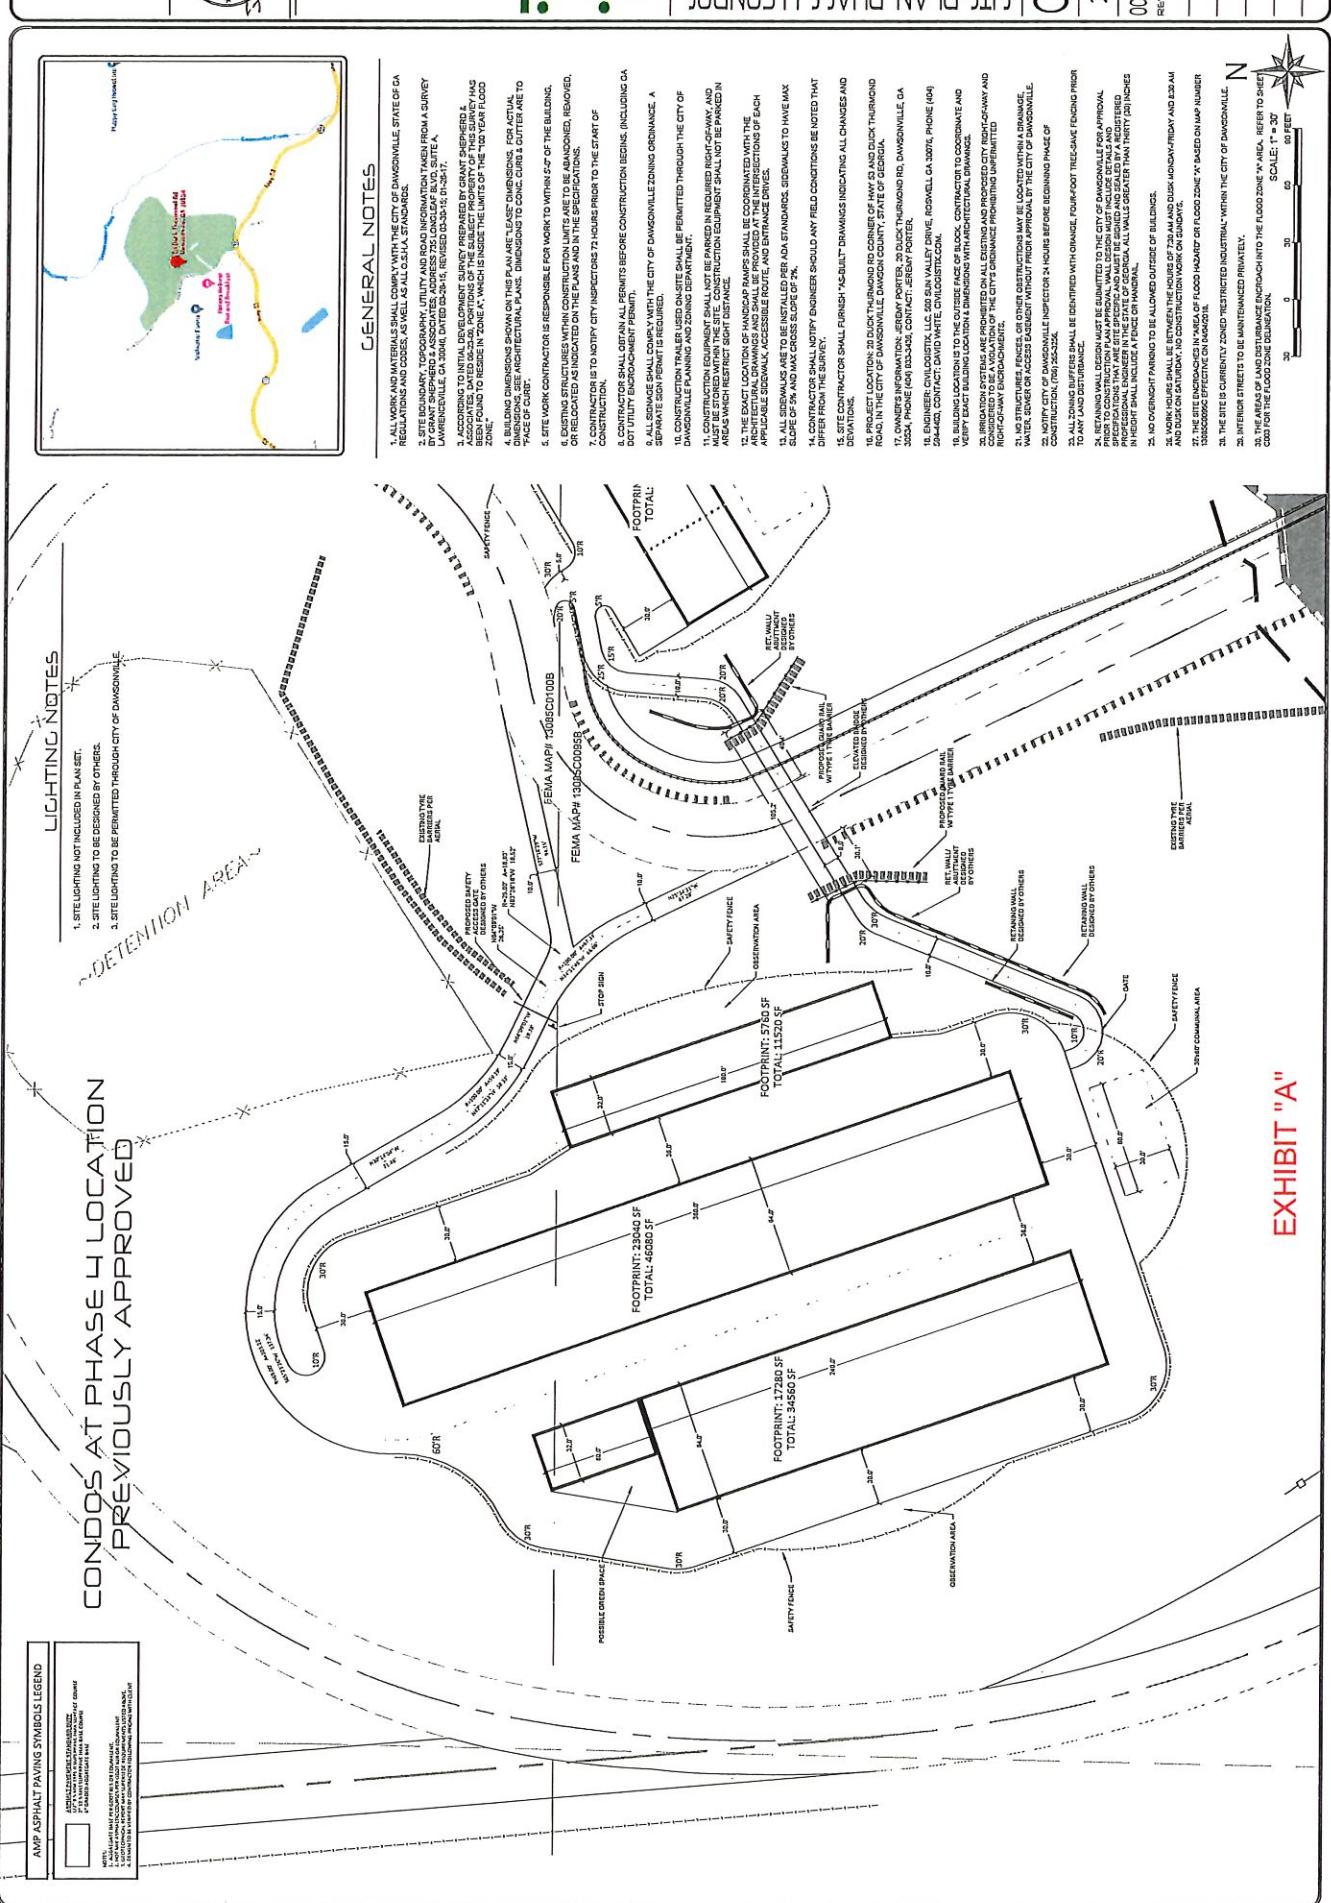



CIVIL OGLISITY

SOO SUN VALLEY DRIVE SITE #3, NOSWELL, GA 30076
(404) 594-4100 - Civilioglisity.com


AMP FUTURE PHASE 5 CONDOS AND BRIDGE SITE PLAN: PHASE 5 CONDOS AND BRIDGE

C202.4

21320

OCTOBER 31, 2027

REVISIONS

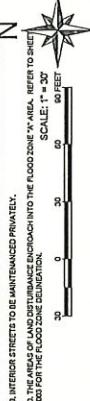

GENERAL NOTES

1. ALL WORK AND MATERIALS SHALL COMPLY WITH THE CITY OF DAWSONVILLE, STATE OF GA, REGULATIONS AND CODES, AS WELL AS LOCAL STANDARDS.
2. SURVEYOR, TOPOGRAPHIC, UTILITY AND DRILL INFORMATION TAKEN FROM A SURVEY BY GRANT SHEPHERD & ASSOCIATES, ADDRESS 710 GLENKIRK BLVD, SUITE A, LAWRENCEVILLE, GA 30044, DATED 03-15-2015, REFERENCED 03-15-2017.
3. ACCORDING TO INITIAL DEVELOPMENT SURVEY PREPARED BY GRANT SHEPHERD & ASSOCIATES, DATED 03-15-2015, PORTIONS OF THE SUBJECT PROPERTY HAS BEEN PLACED IN THE 100-YEAR FLOOD ZONE, WHICH IS LOCATED ON THE PROPERTY OF TWO LEE LOGOS.
4. BUILDING CHANGING SIGN ON THIS PLAN ARE BASED DIMENSION, ACTUAL DIMENSIONS SEE ARCHITECTURAL PLANS, DIMENSIONS TO COC, CURB & CUTTER ARE TO FACE OF CURB.
5. SITE WORK CONTRACTOR IS RESPONSIBLE FOR WORK TO WIDTH OF THE BUILDING, SEE CONTRACTOR'S SPECIFICATIONS FOR DETAILS.
6. ELECTRIC TRACTORS USED ON CONSTRUCTION SITES ARE TO BE BANDED, REMOVED, OR RELOCATED AS INDICATED ON THE PLANS AND IN THE SPECIFICATIONS.
7. CONTRACTOR IS TO NOTIFY CITY INSPECTORS 72 HOURS PRIOR TO THE START OF CONSTRUCTION.
8. CONTRACTOR OR SUBCONTRACTOR IS RESPONSIBLE FOR CONSTRUCTION PERMITS BEFORE CONSTRUCTION BEGINS, INCLUDING GA DOT, UTILITIES, DOB, AND OTHER GOVERNMENT.
9. ALL CONSTRUCTION WORK IS TO BE CONDUCTED IN COMPLIANCE WITH THE CITY OF DAWSONVILLE ZONING ORDINANCE. A SETBACK PLAN FOR THE PROJECT IS TO BE APPROVED BY THE CITY OF DAWSONVILLE PRIOR TO COMMENCEMENT OF CONSTRUCTION.
10. CONTRACTOR IS NOT TO PARK ANY VEHICLES IN THE REQUIRED RIGHT-OF-WAY AND MUST ENSURE THAT THE VEHICLES ARE PARKED IN THE PROVIDED GUEST PARKING AREA WHICH RESTRICTSIGHT DISTANCE.
11. CONTRACTOR IS TO PLACE CONCRETE RAMPS AT THE INTERSECTION OF EACH APPLICABLE SIDEWALK, ACCESSIBLE ROUTE, AND ENTRANCE DRIVES.
12. CONTRACTOR SHALL COORDINATE WITH THE CITY OF DAWSONVILLE FOR THE EXACT LOCATION OF HANDICAP RAMPS WHICH SHALL BE PROVIDED AT THE INTERSECTION OF EACH APPLICABLE SIDEWALK, ACCESSIBLE ROUTE, AND ENTRANCE DRIVES.
13. ALL SIDEWALKS ARE TO BE INSTALLED PER ADA STANDARDS. SIDEWALKS TO HAVE MAX. SLOPE .5% AND MAX CROSS SLOPE .2%.
14. CONTRACTOR SHALL NOTIFY BUILDER IF ANY FIELD CONDITIONS ARE NOT THAT SET FORTH IN THE SURVEY.
15. SITE CONTRACTOR SHALL NOTIFY BUILDER IF ANY FIELD CONDITIONS ARE NOT THAT SET FORTH IN THE SURVEY.
16. PROJECT LOCATION: 20 DUCK THARNDOK RD CORNER OF NWY 53 AND DUCK THARNDOK ROAD, IN THE CITY OF DAWSONVILLE, DAWSONVILLE, STATE OF GEORGIA.
17. OWNER INFORMATION: JEREMY PORTER, 20 DUCK THARNDOK RD, DAWSONVILLE, GA 30534, PHONE: (404) 523-2430, EMAIL: JEREMY@PORTER.COM.
18. ENGINEER: CIVIL LOGISTICS, LLC, 200 SUN VALLEY DRIVE, ROSENDALE, GA 30076, PHONE: 504-442-1200, CONTACT: DAVID WHITE, CIVILLOGISTICS.COM.
19. BUILDING LOCATIONS TO THE OUTSIDE FACE OF BLOCK, CONTRACTOR TO COORDINATE AND VERIFY BUILT BUILDING LOCATION DAWSONVILLE WITH ARCHITECTURAL DRAWINGS.
20. IRRIGATION SYSTEMS ARE PROVIDED ON ALL Existing AND PROPOSED CITY RIGHT-OF-WAY AND CONTRACTOR IS TO MAINTAIN THE CITY'S CIRCUMSTANCE PERTAINING THERETO.
21. CONTRACTOR IS TO MAINTAIN THE CITY'S CIRCUMSTANCE PERTAINING THERETO.
22. NO OVERNIGHT PARKING IS TO BE ALLOWED OUTSIDE OF DAWSONVILLE.
23. NO OVERNIGHT PARKING IS TO BE ALLOWED OUTSIDE OF DAWSONVILLE.
24. RETAINING WALLS MUST BE SUBMITTED TO THE CITY OF DAWSONVILLE FOR APPROVAL PRIOR TO CONSTRUCTION. PLANS MUST INCLUDE ALL DETAILS AND SPECIFICATIONS FOR THE RETAINING WALLS AND THE RETAINING WALLS MUST BE DESIGNED AND BUILT AS REQUESTED IN HEIGHT. WALLS INCLUDE A PLATE ON AN ANGLE.
25. NO OVERNIGHT PARKING IS TO BE ALLOWED OUTSIDE OF DAWSONVILLE.
26. THE SITE IS LOCATED IN THE AREA OF FLOOD HAZARD ON FLOOD ZONE "X" BASED ON MAP NUMBER FLOODZONE EFFECTIVE ON NOVEMBER 1, 2025.
27. INTERIOR STREET IS TO BE MAINTAINED PAVED.
28. THE AREA OF LAND SURFACE APPROACH INTO THE FLOOD ZONE "X" MUST REFER TO SHEET C202.4 FOR THE FLOOD ZONE BOUNDARY.

CONDOS AT PHASE 5 LOCATION PREVIOUSLY APPROVED


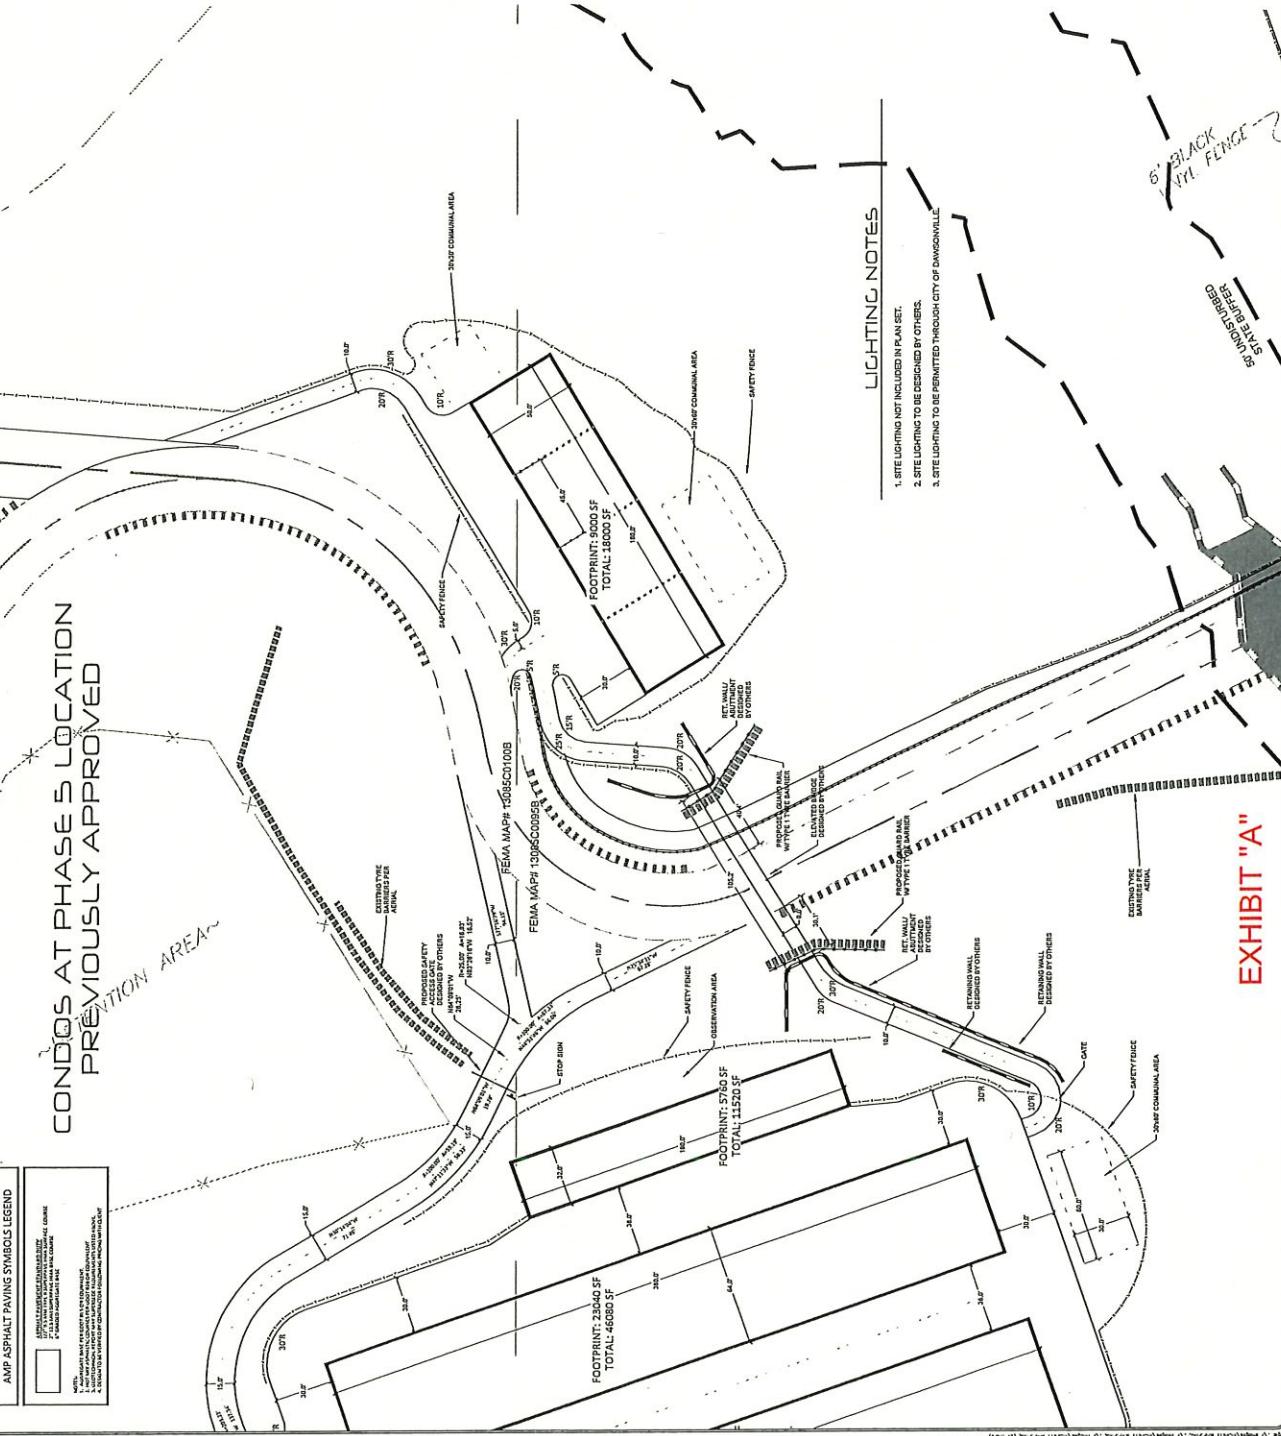


EXHIBIT "A"

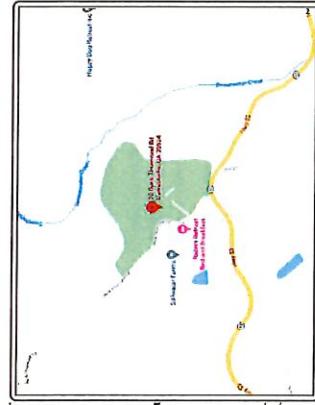

GENERAL NOTES


1. ALL WORK AND MATERIALS SHALL COMPLY WITH THE CITY OF DAWSONVILLE, STATE OF GA, REED & WILCOX AND CODES, AS WELL AS LOCAL ORDINANCES.
2. SITE BOUNDARY, PROPERTY LINE, UTILITY AND ROAD INFORMATION TAKEN FROM A SURVEY LIAWNECKLE & CO. DATED OCT 2014, REVISED SURVEY DATED ON 2017.
3. ACCORDING TO INITIAL DECONTRACT SURVEY PREPARED BY GRIFFIN SURVEYORS & CO., INC. ASSOCIATES, DATED 10-24-08, PORTIONS OF THE SUBJECT PROPERTY OF THIS SURVEY HAS BEEN FOUND TO EXIST IN "ZONE A", WHICH IS INSIDE THE LIMITS OF THE "100 YEAR FLOOD ZONE".
4. BUILDING DIMENSIONS SHOWN ON THESE PLANS ARE "CLEAR" DIMENSIONS. FOR ACTUAL TRADE OR CARRIAGE, ADDITIONAL PLANS, ADJUSTED TO "CUBIC" CUBE & GUTTER AREA TO PLACE OF CARE.
5. SITE WORK CONTRACTOR IS RESPONSIBLE FOR WORK TO WITHIN 5'-0" OF THE BUILDING.
6. EXISTING STRUCTURES WITHIN CONSTRUCTION LIMITS ARE TO BE ABANDONED, REMOVED, OR RELOCATED AS INDICATED ON THE PLANS AND IN THE SPECIFICATIONS.
7. CONTRACTOR IS TO NOTIFY CITY INSPECTOR 72 HOURS PRIOR TO THE START OF CONSTRUCTION.
8. CONTRACTOR SHALL OBTAIN ALL PERMITS BEFORE CONSTRUCTION BEGINS, INCLUDING DAQD UTILITY ENHANCEMENT PERMIT.
9. ALL SOURCE SHALL COPY WITH THE CITY OF DAWSONVILLE ZONING ORDINANCE, A SEPARATE SOURCE REPORT IS REQUIRED.
10. CONSTRUCTION TRAILER USED ON SITE SHALL BE PERMITTED THROUGH THE CITY OF DAWSONVILLE PLANNING AND ZONING DEPARTMENT.
11. CONSTRUCTION EQUIPMENT SHALL NOT BE PARKED IN REQUIRED RIGHT-OF-WAY, AND AS SUCH, SHALL NOT BE STORED NEAR THE SITE. CONSTRUCTION EQUIPMENT SHALL NOT BE PARKED IN ANY PUBLIC RIGHT-OF-WAY.
12. THE COAST LOCATION OF THE HAZARD RAMPS SHALL BE COORDINATED WITH THE CITY OF DAWSONVILLE.
13. APPROPRIATE STABILIZATION MEASURES SHALL BE TAKEN AT THE END OF EACH ACCESSIBLE ROUTE AND ENTRANCE DRIVE.
14. ALL ELDERSWALS ARE TO BE INSTALLED PER STANDARDS, SPECIFIED TO HAVE MAX SLOPE OF 6% AND MAX CROSS SLOP OF 2%.

15. CONTRACTOR SHALL NOTIFY ENGINEER SHOULD ANY FIELD CONDITIONS BE NOTED THAT DIFFER FROM THE SURVEY.
16. SITE CONTRACTOR SHALL FURNISH "AS-BUILT" DRAWINGS INDICATING ALL CHANGES AND DEVIATIONS.
17. PROJECT LOCATED ON PROPERTY OWNED BY DAVIDSON COUNTY, GA, 1000 HIGHWOOD ROAD, IN THE CITY OF DAWSONVILLE, DAVIDSON COUNTY, GA, 30534. PROJECT LOCATED ON PROPERTY OWNED BY DAVIDSON COUNTY, GA, 1000 HIGHWOOD ROAD, IN THE CITY OF DAWSONVILLE, DAVIDSON COUNTY, GA, 30534.
18. CONTRACTOR INFORMATION: BREANAN MOORE & DODGE, TURNER ID: DAWSONVILLE, GA, PHONE: (404) 824-2400, CONTACT: JEREMY PORTER
19. ENGINEER: GUY COOPER LLC, 100 SAN VALLEY DRIVE, ROSWELL, GA 30076, PHONE (404) 592-4400, CONTACT: DUSTY WATTS, CO-OWNER
20. DAQD APPROVALS SHALL BE OBTAINED FROM THE CITY OF DAWSONVILLE AND DUSK CONSTRUCTION FRIDAY AND 8:30 AM AND 8:00 PM SATURDAY.
21. DAQD APPROVALS SHALL BE OBTAINED FROM THE CITY OF DAWSONVILLE AND DUSK CONSTRUCTION FRIDAY AND 8:30 AM AND 8:00 PM SATURDAY.
22. ALL DUGGING HUMPS SHALL BE IDENTIFIED IN AN ORANGE, FOUR-HORN TREE-SAVE TRENCH PRIOR TO ANY DUGGING.
23. RETAINING WALL DESIGN MUST BE SUBMITTED TO THE CITY OF DAWSONVILLE FOR APPROVAL. SPECIFICATIONS THAT ARE NOT SPECIFIC TO THE STATE OF GEORGIA, ALL WALLS GREATER THAN THIRTY (30) INCHES IN THICKNESS, AND RETAINING WALLS GREATER THAN TWENTY (20) FEET IN LENGTH MUST BE SUBMITTED TO THE CITY OF DAWSONVILLE.
24. NO OVERHANG PAVING TO BE ALLOWED OUTSIDE OF BUILDING.
25. WORK HOURS SHALL BE REVERSED THE HOURS OF 2:00 AM AND DUSK CONSTRUCTION FRIDAY AND 8:30 AM AND 8:00 PM SATURDAY.
26. SITE LIGHTING NOT INCLUDED IN MAP NUMBER 20.
27. INTERNAL STREETS TO BE MAINTAINED PRIVATELY.
28. THE EDGE OF LAND DISTURBANCE DRAUGH TO THE FLOOD ZONE "X" AREA REFER TO SET 20 FOR THE FLOOD ZONE DELIMITATION.

SCALE: 1"-0" = 40'-0" FT
20 40 60 FEET
N
EXHIBIT "A"

LIGHTING NOTES

1. SITE LIGHTING NOT INCLUDED IN MAP SET.
2. SITE LIGHTING TO BE DESIGNED BY OWNERS.
3. SITE LIGHTING TO BE REMITTED THROUGH CITY OF DAWSONVILLE.

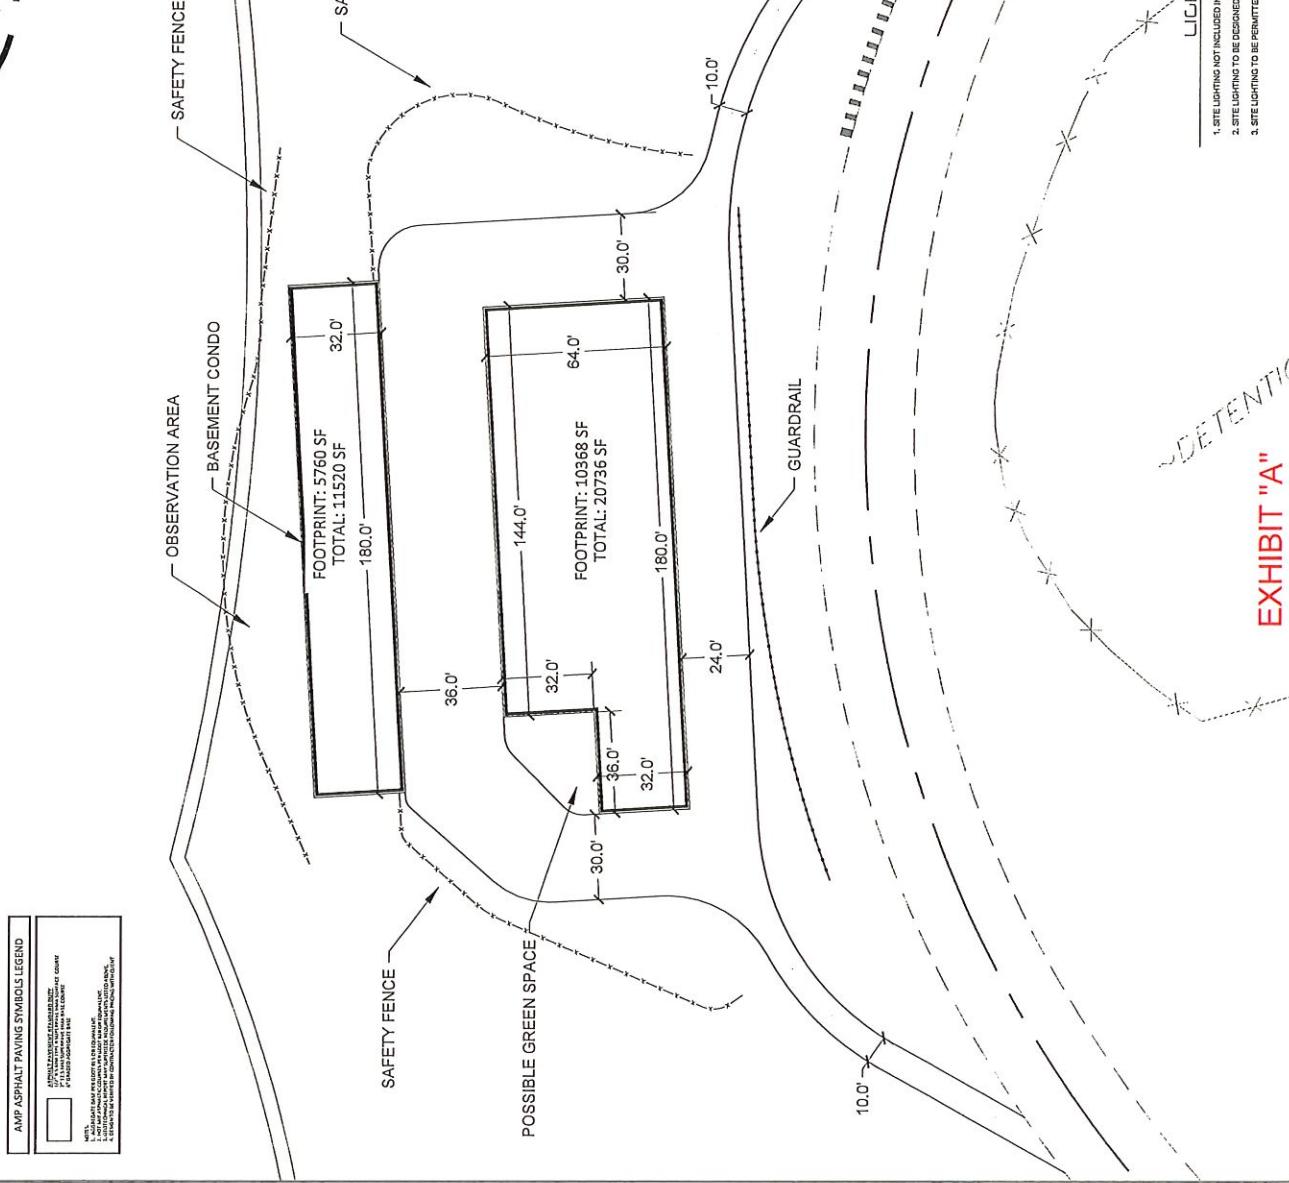



GENERAL NOTES

1. ALL WORK AND MATERIALS SHALL COMPLY WITH THE CITY OF DAWSONVILLE, STATE OF GA, BUILDING, TOPOGRAPHICAL, UTILITY AND ROAD INFORMATION TAKEN FROM A SURVEY LIAISONED IN ASHEVILLE ON DATE DEC-2014, REVISED DEC-15, 2015.

2. ACCORDING TO ITINERARY SURVEY OF SUBJECT PROPERTY CONDUCTED IN 2014, PORTIONS OF THE SUBJECT PROPERTY OF THIS PROPERTY HAS BEEN FOUND TO RESIDE IN 'ZONE A', WHICH IS INSIDE THE LIMITS OF THE '100 YEAR FLOOD ZONE'.

3. BUILDING DIMENSIONS SHOWN ON THIS PLAN ARE 'LEAF' DIMENSIONS. FOR ACTUAL CONSTRUCTION, ARCHITECTURAL PLANS, DIMENSIONS TO CORNERS & CENTER ARE TO ESTABLISH.

4. CONTRACTOR SHALL OBTAIN ALL PERMITS BEFORE CONSTRUCTION BEGINS, INCLUDING GA DOT UTILITY ENHANCEMENT PERMIT.

5. SITE WORK CONTRACTOR RESPONSIBLE FOR WORK TO EXTERIOR 5' FT OF THE BUILDING.

6. EXISTING STRUCTURES WITHIN CONSTRUCTION LIMITS ARE TO BE ABANDONED, REMOVED, OR RELOCATED AS INDICATED ON THE PLANS AND IN THE SPECIFICATIONS.

7. CONTRACTOR IS TO NOTIFY CITY INSPECTORS 72 HOURS PRIOR TO THE START OF CONSTRUCTION.

8. CONTRACTOR SHALL OBTAIN ALL PERMITS BEFORE CONSTRUCTION BEGINS, INCLUDING GA DOT UTILITY ENHANCEMENT PERMIT.

9. ALL SIGNAGE SHALL COMPLY WITH THE CITY OF DAWSONVILLE ZONING ORDINANCE. A SEPARATE SIGNAGE UNIT REQUIRED.

10. CONSTRUCTION TRAILER USED ON SITE SHALL BE PERMITTED THROUGH THE CITY OF DAWSONVILLE PLANNING AND ZONING DEPARTMENT.

11. CONSTRUCTION EQUIPMENT SHALL NOT BE PARKED IN REQUIRED RIGHT-OF-WAY AND MUST BE STORED ATXIN THE SITE. CONSTRUCTION EQUIPMENT SHALL NOT BE PARKED IN ANY APPROPRIATE AREA.

12. THE exact location of the manhole ramps shall be coordinated with the applicable street authority and contractor prior to installation of such ramps.

13. ALL SIGNALS ARE TO BE INSTALLED PER ADA STANDARDS, SIDEWALKS TO HAVE MAX SLOP OF 1% AND MAX CROSS SLOPE OF 2%.

14. CONTRACTOR SHALL NOTIFY ENGINEER SHOULD ANY FIELD CONDITIONS BE NOTED THAT DIFFER FROM THE SURVEY.

15. SITE CONTRACTOR SHALL FURNISH "AS-BUILT" DRAWINGS INDICATING ALL CHANGES AND ALTERATIONS.

16. CONTRACTOR SHALL COORDINATE WITH THE CITY OF DAWSONVILLE FOR WATER AND SEWER CONNECTIONS TO THE NEWLY BUILT BUILDING.

17. OWNER/INTEREST BEGAN ON RIVER RD., 20 DUCTRIN, JURISDICTION OF DAWSONVILLE, GA 30534, PHONE #671-3004, CONTACT: SEBASTIAN GREGORY.

18. ENGINEER: JOHN DOBBINS, LLC, 100 SAVANNAH DRIVE, ROSWELL, GA 30076, PHONE #670-525-4400, EMAIL: JDOBBINS@JOHNDOBBISSLLC.COM.

19. WORKING BUFFERS SHALL BE IDENTIFIED ON DRAWINGS, ONE-FOOT FREE-SAFE FENCING PRIORITY AND DESIGNATED ON WORK AREAS.

20. RETAINING WALLS SHALL BE SUBMITTED TO THE CITY OF DAWSONVILLE FOR APPROVAL. THE CITY OF DAWSONVILLE MAY REQUIRE THE CONTRACTOR TO PREPARE A DRAWING OF THE RETAINING WALL AND PROVIDE A BIDDING BID.

21. NO STRUCTURES, FENCES OR OTHER OBSTRUCTIONS MAY BE LOCATED WITHIN A BRANCH, WATERWORK OR ACCESS DURING PERMIT APPROVAL BY THE CITY OF DAWSONVILLE.

22. NOTIFY CITY OF DAWSONVILLE INSPECTOR 3 HOURS BEFORE EINING PHASE OF CONSTRUCTION. (706) 322-2202.

23. ALL ZONING BUFFERS SHALL BE IDENTIFIED ON DRAWINGS.

24. WORKING SPACES SHALL NOT OVERLAP ON DRAWINGS OR ON DRAWSITES.

25. THE SITE ENCROACHES ON A SEGMENT OF FLOODWAY OR FLOOD ZONE. A BASED ON A MAP NUMBER

N.

26. THE SITE IS CURRENTLY ZONED RESTRICTED INDUSTRIAL, WITHIN THE CITY OF DAWSONVILLE, GA. INTERIOR STREETS TO BE MAINTAINED PRIVATELY.

27. THE AREA OF LAND RESTRAINED DUE TO THE FLOOD ZONE "A" AREA, REFER TO SHEET COO FOR THE FLOOD ZONE ELEVATION.

28. 000 FEET

EXHIBIT "A"




LIGHTING NOTES

1. SITE LIGHTING NOT INCLUDED IN PLAN SET.

2. STELLIGHTING TO BE DESIGNED BY OTHERS.

3. SITE LIGHTING TO BE PERMITTED THROUGH CITY OF DAWSONVILLE.

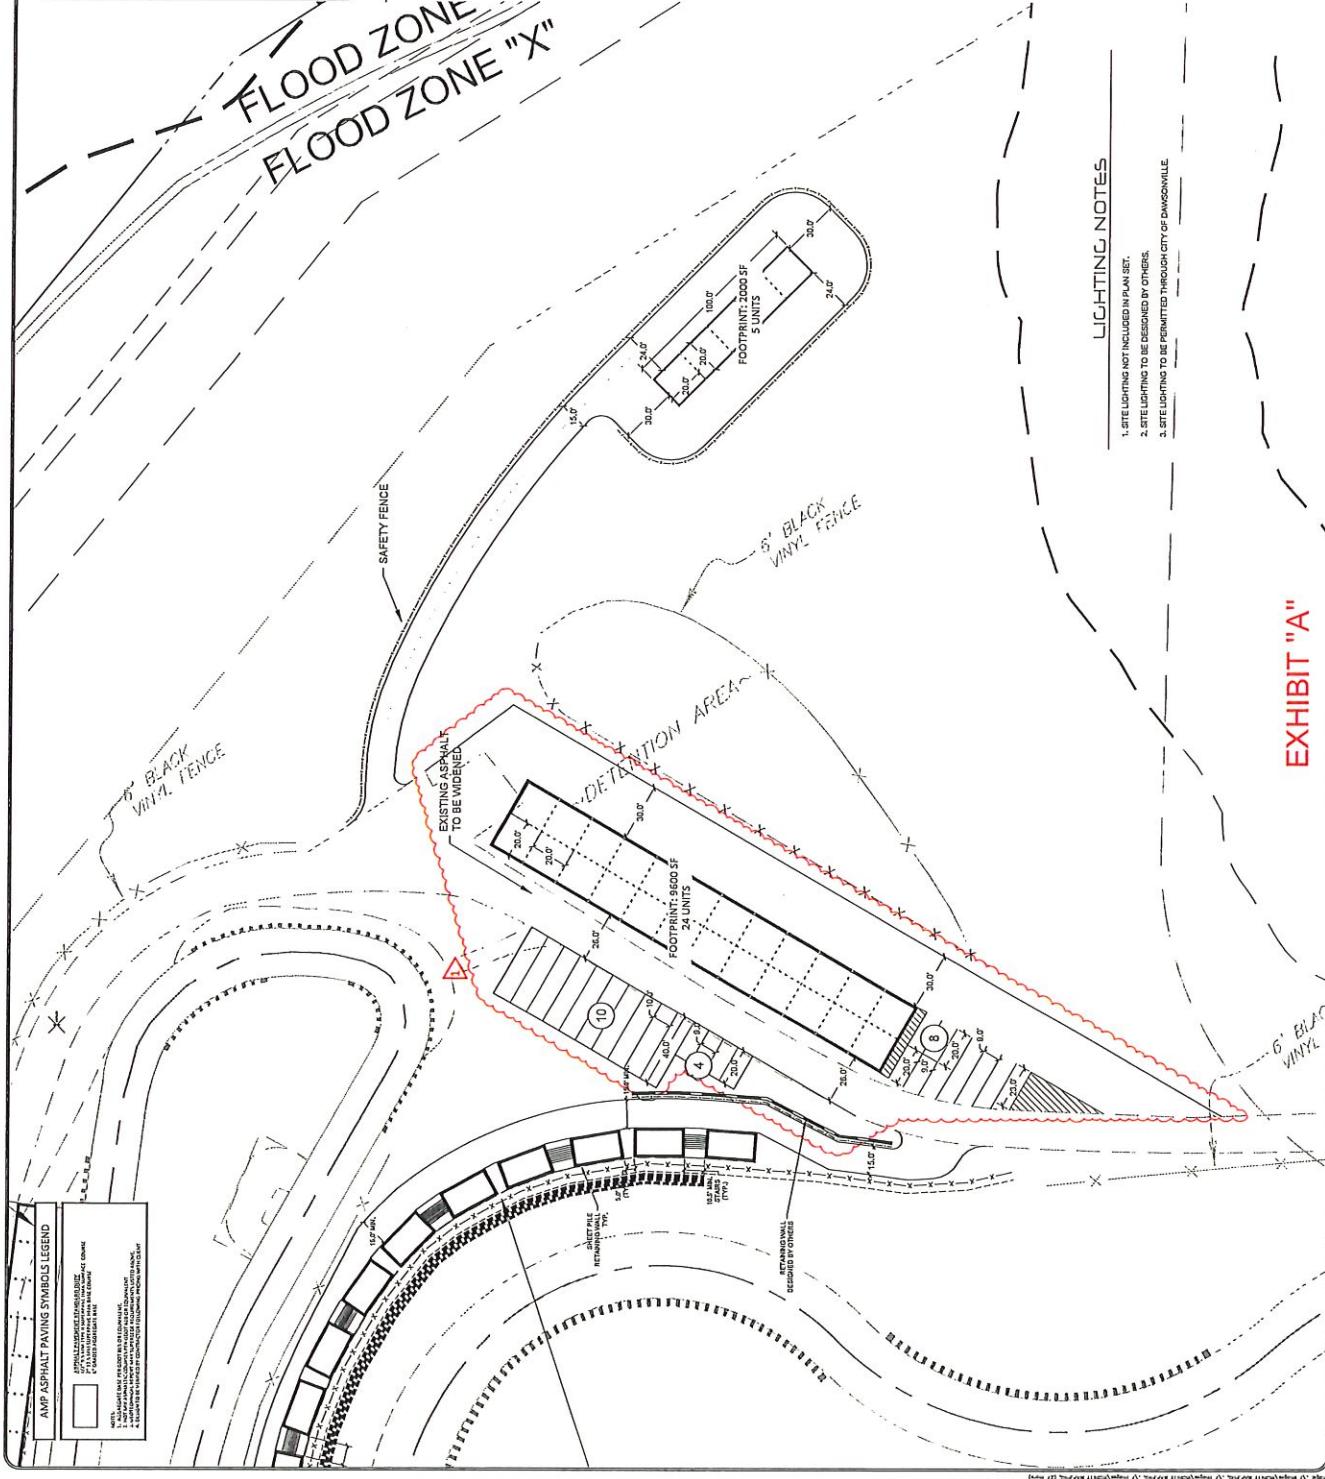



CIVIL OCULISTS

500 SUN VALLEY DRIVE, STE 3, ROSWELL, GA 30076
(404) 591-4403 - CiviliOculists.com

C202.8

213120

OCTOBER 31, 2022

REVISION COMMENTS
04-27-23
OWNER COMMENTS
05-30-23


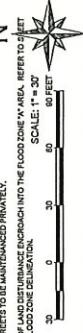


EXHIBIT "A"



CIVIL OBLIGATIONS

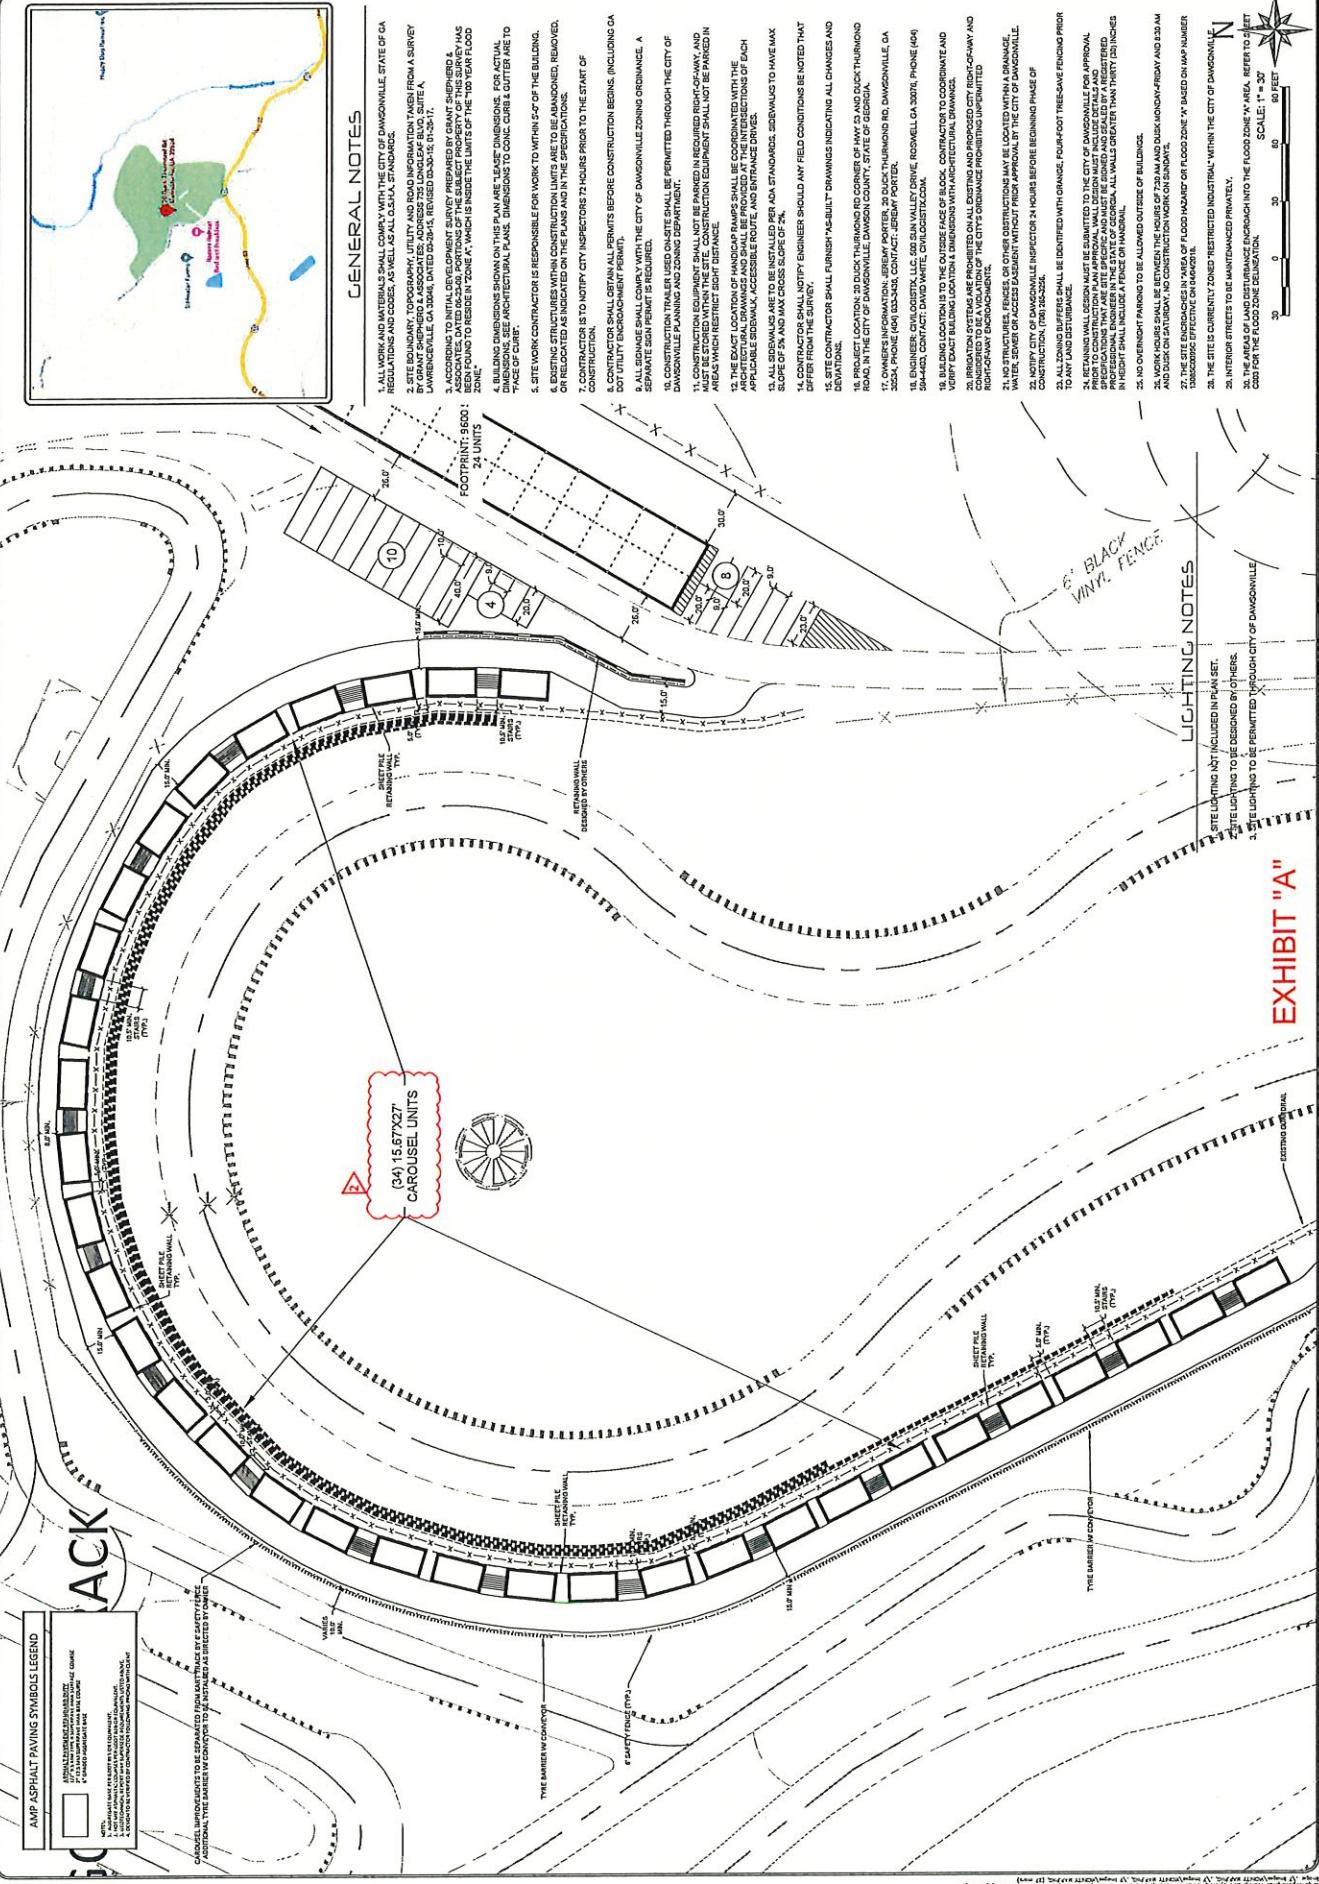


500 SUI VALLEY DR., STE. H, ROSWELL, GA 30076
(404) 591-4103 - Chelgis@cityof.com

AMPL FUTURE IMPROVEMENTS
SITE PLAN: TURN 6 BUILDINGS

DAWSONVILLE, GA 30541


C202.9

OCTOBER 21, 2022
REVISED
NO. 2
ON 10/27/23
OWNER COMMENTS
C2-50-23

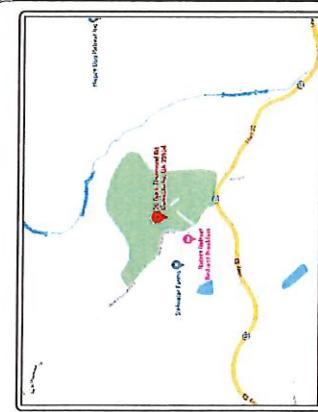

GENERAL NOTES

1. ALL WORK AND MATERIALS SHALL COMPLY WITH THE CITY OF DAWSONVILLE, STATE OF GA, REGULATIONS AND CODES AS WELL AS THE CITY OF DAWSONVILLE'S ZONING ORDINANCE.
2. OFFICIAL RECORDS OF PLAT, SURVEY AND RECORDS OF PLAT, SURVEY AND RECORDS OF SURVEY BY CHAMBERS SURVEYING & ENGINEERING CO., INC. AND RECORDS OF SURVEY FROM A SURVEY BY LAWRENCEVILLE, GA, 30050, DATED 05-25-15, REVISED 05-25-17.
3. ACCORDING TO INITIAL DEVELOPMENT SURVEY PERIODIC BY GRANT, SURVEYOR & ASSOCIATES, DATED 07-07-2010, PORTIONS OF THE SUBJECT PROPERTY OF THIS SURVEY HAS BEEN FOUND TO RESIDE IN "ZONE A", WHICH IS INSIDE THE LIMITS OF THE "100 YEAR FLOOD ZONE".
4. BUILDING DIMENSIONS SHOWN ON THE PLANS ARE "TRUE" DIMENSIONS. FOR ACTUAL BUILDING DIMENSIONS, REFER TO CONC. CUBIC CUTTER TO FACE OF CURB.
5. SITE WORK CONTRACTOR IS RESPONSIBLE FOR WORK TO WITHIN 5'-0" OF THE BUILDING. EXISTING STRUCTURES WITHIN CONSTRUCTION LIMITS ARE TO BE ABANDONED, REMOVED, OR RELOCATED IN ACCORDANCE WITH THE PLANS AND IN SPECIFICATIONS.
6. CONTRACTOR IS TO NOTIFY CITY INSPECTORS 72 HOURS PRIOR TO THE START OF CONSTRUCTION.
7. CONTRACTOR SHALL OBTAIN ALL PERMITS BEFORE CONSTRUCTION BEGINS, INCLUDING GA DOU UTILITY ENCROACHMENT PERMIT.
8. ALL SIGNAGE SHALL COMPLY WITH THE CITY OF DAWSONVILLE ZONING ORDINANCE. A SEPARATE LEAD-IN REQUIRED.
9. CONSTRUCTION TRAILER USED OUTSIDE SHALL BE PERMITTED THROUGH THE CITY OF DAWSONVILLE PLANNING AND ZONING DEPARTMENT.
10. CONSTRUCTION EQUIPMENT SHALL NOT BE PARKED IN REQUIRED RIGHT-OF-WAY, AND AREA SURVEYED BY ENGINEER SHALL NOT BE ENTERED.
11. THE POINT OF LOADING OF CONSTRUCTION EQUIPMENT RAMP SHALL BE COORDINATED WITH THE APPLICABLE SIDEWALK, ACCESS ROUTE, AND ENTRANCE DRIVES.
12. ALL SIDEWALKS ARE TO BE INSTALLED PER ADA STANDARDS. SIDEWALKS TO HAVE MAX SLOP OF 1% AND MAX CROSS SLOP OF 2%.
13. CONTRACTOR SHALL NOTIFY ENGINEER SHOULD ANY FIELD CONDITIONS BE NOTED THAT DIFFER FROM THE SURVEY.
14. SITE CONTRACTOR SHALL FURNISH "AS-BUILT" DRAWINGS INDICATING ALL CHANGES AND DIVISIONS.
15. PRODUCERS OF CONCRETE SHALL PROVIDE CONCRETE TO THE CITY OF DAWSONVILLE, DAWSONVILLE COUNTY, STATE OF GEORGIA, AND DAWSON COUNTY, STATE OF GEORGIA, IN THE CITY OF DAWSONVILLE, DAWSONVILLE, GA, 30541, PHONE 770-923-5420, FAX 770-923-5421, GMAIL: JERRY.PORTER@CITY.DA.WV.GA.US.
16. BUSINESS OR GOVERNMENT, LLC, 1555 SUBLAWFUL DRIVE, KENNESAW, GA 30056, 504-446-CONTACT, DAVID WALTER, CHA CONSTRUCT CO.
17. BUILDING LOCATED ON 20 BUCK TURNBULL RD, DAWSONVILLE, GA, PHONE (404) 361-0010, TO BE DEMOLISHED.
18. TURN 6 BUILDINGS ARE TO BE DEMOLISHED AND RELOCATED OUTSIDE OF THE 100-YEAR FLOOD ZONE AND TO DO SO OUTSIDE OF THE 100-YEAR FLOOD ZONE AND TURN 6 BUILDINGS ARE TO BE DEMOLISHED AND RELOCATED OUTSIDE OF THE 100-YEAR FLOOD ZONE AND TURN 6 BUILDINGS ARE TO BE DEMOLISHED AND RELOCATED OUTSIDE OF THE 100-YEAR FLOOD ZONE.
19. TURN 6 BUILDINGS ARE TO BE DEMOLISHED AND RELOCATED OUTSIDE OF THE 100-YEAR FLOOD ZONE AND TURN 6 BUILDINGS ARE TO BE DEMOLISHED AND RELOCATED OUTSIDE OF THE 100-YEAR FLOOD ZONE.
20. NO CONSTRUCTION OR DEMOLITION ACTIVITY SHALL OCCUR WITHIN THE 100-YEAR FLOOD ZONE.
21. NO CONSTRUCTION ACTIVITY SHALL OCCUR WITHIN THE 100-YEAR FLOOD ZONE.
22. NO CONSTRUCTION ACTIVITY SHALL OCCUR WITHIN THE 100-YEAR FLOOD ZONE.
23. ALLOTTED DUFFERS SHALL BE IDENTIFIED WITHANGE, FOUR-FOOT TREE-SAVE FENCING, PRIOR TO LAND CLEARANCE.
24. RETAINING WALL DESIGN MUST BE SUBMITTED TO THE CITY OF DAWSONVILLE FOR APPROVAL. DESIGNATION THAT ARE NOT SPECIFIC AND MUST BE DESCRIBED AND STATED AS A REQUIREMENT, INCLUDING IN THE STATE OF GEORGIA, ALL WALLS GREATER THAN THIRTY (30) FEET IN LENGTH, SHALL BE APPROVED BY THE CITY OF DAWSONVILLE.
25. NO OVERNIGHT PARKING TO BE ALLOWED OUTSIDE OF BUILDINGS.
26. WORKING HOURS SHALL BE BETWEEN THE HOUR OF 7:00 AM AND 6:00 PM MONDAY-FRIDAY AND 8:00 AM AND 5:00 PM SATURDAY. NO OPERATION ON SUNDAY OR HOLIDAYS.
27. NO SITE ENCROACHMENTS IN AREA OF FLOOD HAZARD OR FLOOD ZONE. X MARKED ON MAP NUMBER 28. THE SITE IS CURRENTLY ZONED RESTRICTED INDUSTRIAL WITHIN THE CITY OF DAWSONVILLE.
29. INTERIOR STREET TO BE MAINTAINED PRIVATELY.
30. THE AREA OF LAND DISTURBANCE INCORPORATED INTO THE FLOOD ZONE "X" AREA, REFER TO SHEET 20 FOR THE FLOOD ZONE DELIMITED.

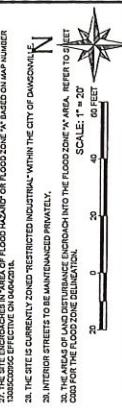


LIGHTING NOTES

- 1. SITE LIGHTING NOT INCLUDED IN PLAN SET.
- 2. SITE LIGHTING TO BE DESIGNED BY OWNERS.
- 3. SITE LIGHTING TO BE PERMITTED THROUGH CITY OF DAWSONVILLE.

EXHIBIT "A"

AMP ASPHALT PAVING SYMBOLS LEGEND	
Asphalt Pavement	Symbol: A solid rectangle with diagonal hatching across it.
Asphalt Pavement with Expansion Joint	Symbol: A solid rectangle with a vertical line through the center representing an expansion joint.
Asphalt Pavement with Reinforcement	Symbol: A solid rectangle with diagonal hatching across it and small diagonal lines extending from the top and bottom edges.

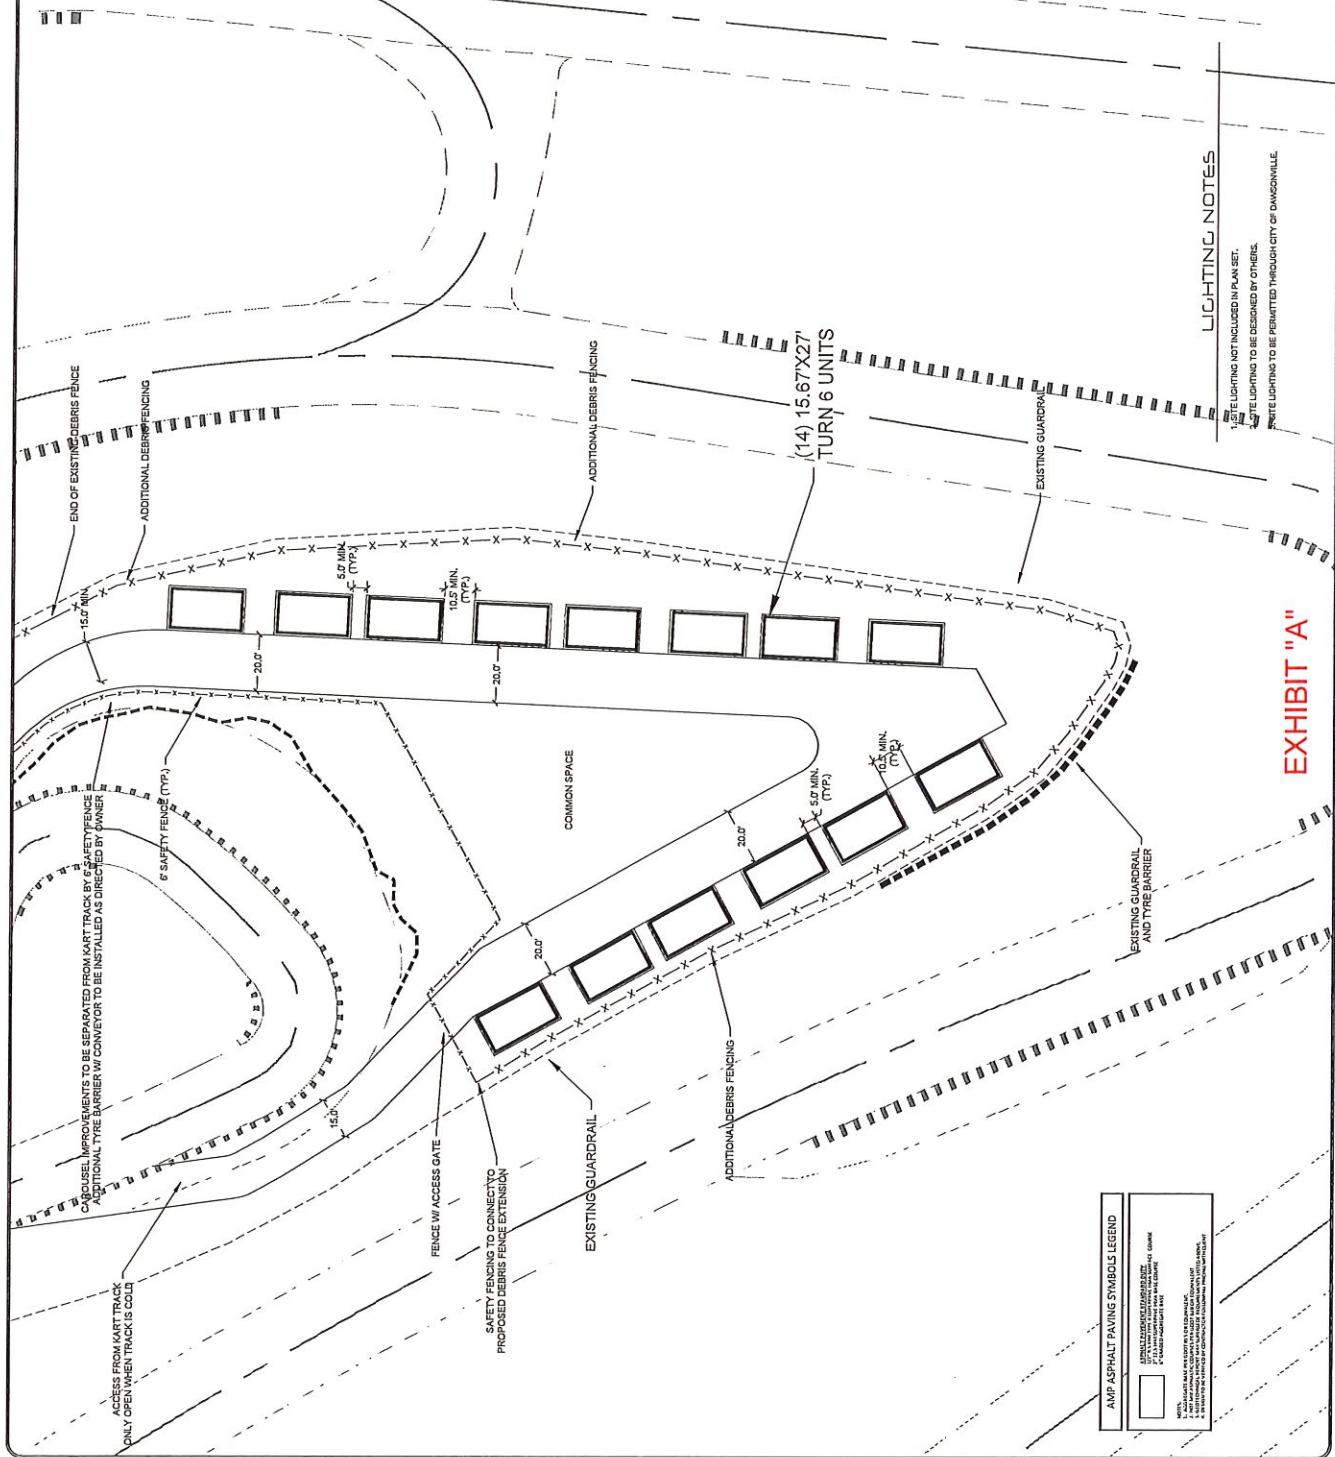



CIVIL OCULISTIX

SITE PLAN, ELEVATED GO-KART CONDOS
AM/FUTURE IMPROVEMENTS
DAWSONVILLE RD, DAWSONVILLE, GA 30078
(404) 594-4103 - CiviliOculistix.com

C202.10
21320
OCTOBER 31, 2027
REV 09/23



N
SCALE: 1" = 40'-0"
40'-0" 30'-0" 20'-0" 10'-0"

EXHIBIT "A"

LIGHTING NOTES


1. SITE LIGHTING NOT INCLUDED IN PLAN SET.
2. SITE LIGHTING TO BE DESIGNED BY OWNER.
3. SITE LIGHTING TO BE PERMITTED THROUGH CITY OF DAWSONVILLE.




GENERAL NOTES

1. ALL WORK AND MATERIALS SHALL COMPLY WITH THE CITY OF DAWSONVILLE, STATE OF GA, REGULATIONS AND CODES, AS WELL AS ALL U.S.A. STANDARDS.
2. SITE BOUNDARY, TOPOGRAPHY, UTILITY AND ROAD INFORMATION TAKEN FROM A SURVEY BY GRANT SHEPHERD & ASSOCIATES, ADDRESS 755 LONGVIEW BLVD, SUITE A, LAWRENCEVILLE, GA 30050, DAILED 05-15, REVISED 05-05-17.
3. ASSOCIATES DATE 05-25-17. PORTION OF THIS SURVEY HAS BEEN ADJUSTED FOR THE ELEVATION OF THE TWO FEET OF SOIL THAT HAS BEEN REMOVED IN ZONE A, WHICH IS EQUAL TO THE EARTH OF THE TWO FEET OF SOIL THAT HAS BEEN REMOVED IN ZONE B.
4. BUILDING DIMENSIONS SHOWN ON THIS PLAN ARE USED FOR DESIGN PURPOSES. FOR ACTUAL DIMENSIONS, SEE ARCHITECTURAL PLANS, DIVISIONS TO CONCRETE CURB & GUTTER AREA TO FACE OF CURB.
5. SITE WORK CONTRACTOR IS RESPONSIBLE FOR WORK WITHIN 50' OF THE BUILDING.
6. CERTAIN STRUCTURES WITHIN CONSTRUCTION HAD TO BE DEMOLISHED, REMOVED, OR RELOCATED AS INDICATED ON THE PLANS AND IN THE SPECIFICATIONS.
7. CONTRACTOR IS TO NOTIFY CITY INSPECTORS 72 HOURS PRIOR TO THE STATE OF CONSTRUCTION.
8. CONTRACTOR SHALL OBTAIN ALL PERMITS BEFORE CONSTRUCTION BEGINS, INCLUDING GA DOU UTILITY ENRICHMENT PERMIT.
9. BILL OF SALE SHALL COME FROM THE CITY OF DAWSONVILLE ZONING ORDINANCE, A SEPARATE BILL OF SALE IS REQUIRED.
10. CONSTRUCTION TRAILER MUST BE PLACED ON THE SITE AND BE PERMITTED THROUGH THE CITY OF DAWSONVILLE PLANNING AND ZONING DEPARTMENT.
11. CONTRACTOR SHALL MAINTAIN A SITE CLEAN UP PLAN AND BE ADVISED IN WRITING OF REQUIREMENTS FOR PAYMENT AND METHODS OF PAYMENT WHICH RESTRICT SITE CLEAN UP PAYMENT.
12. THE EXACT LOCATION OF HANDICAP RAMPS SHALL BE COORDINATED WITH THE ARCHITECTURAL DRAWINGS AND SHALL BE PROVIDED AT THE INTERSECTIONS OF EACH APPLICABLE SIDEWALK, ACCESSIBLE ROUTE, AND ENTRANCE DRIVES.
13. ALL SIDEWALKS ARE TO BE INSTALLED PER ADA STANDARDS. SIDEWALKS TO HAVE MAX SLOPE AND MAX CROSS-SLOPE OF 2%.
14. CONTRACTOR SHALL NOTIFY BUILDER SHOULD ANY FIELD CONDITIONS BE NOTED THAT DIFFER FROM THE SURVEY.
15. SITE CONTRACTOR SHALL FURNISH "AS-BUILT" DRAWINGS INDICATING ALL CHANGES AND DEVIATIONS.
16. PROJECT LOCATION: 20 DUCK THIMBLED RD CORNER OF HWY 23 & DUCK THIMBLED RD, DAWSONVILLE, GA 30050. PHONE: (404) 593-8420 / FAX: (404) 593-8421.
17. OWNERS INFORMATION: JEFFREY PORTER, 20 DUCK THIMBLED RD, DAWSONVILLE, GA 30050. PHONE: (404) 593-8420 / FAX: (404) 593-8421.
18. ENGINEER: CIVILOGISTICS LLC, 500 SUN VALLEY DRIVE, DOWNSIDE, GA 30050. PHONE: (404) 593-4460. CO-OP: DAYWHITE, CLOUDWHITE.COM.
19. BUILDING LOCATIONS IS TO THE OUTSIDE EDGE OF BLOCK. CONTRACTOR TO COORDINATE AND VERIFY DRAFT BUILDING LOCATIONS WITH CONTRACTOR DRAWINGS.
20. IRRIGATION SYSTEMS ARE PREFERRED TO ALL DESTROY AND PROPOSED CITY RIGID CRANES AND TO USE THE EXISTING SPRINKLER SYSTEMS.
21. CONTRACTOR SHALL PROVIDE A VACUUM EXTRACTOR TO VACUUM EXCAVATION DUST.
22. EXCAVATION DUST SHALL BE COLLECTED WITH DRAPES, TARP, AND PLASTIC TARP.
23. ALL ZONING DIFFERENTS SHALL BE IDENTIFIED WITH DRAPES, TARP, PLASTIC TARP, AND VINYL FENCE.
24. RETAINING WALL DESIGN MUST BE SUBMITTED TO THE CITY OF DAWSONVILLE FOR APPROVAL, PRIOR TO CONSTRUCTION. PLAN APPROVAL, WALL DESIGN MUST INCLUDE DETAILS AND DRAWINGS FOR ALL RETAINING WALLS, WHETHER THEY ARE EXISTING OR NEW. CONTRACTOR IS TO PROVIDE A DRAFTER IN THE STATE OF GEORGIA, WHO IS REGISTERED AND PRACTICING IN THE STATE OF GEORGIA, AND DETERMINED BY THE CITY OF DAWSONVILLE. IN HEIGHT, SHALL INCLUDE A FENCE OR HANDBAR.
25. NO OVERNIGHT PARKING TO BE ALLOWED OUTSIDE OF BUILDINGS.
26. WORK HOURS SHALL BE BETWEEN THE HOURS OF 7:00 AM AND 6:00 PM MONDAY-FRIDAY AND 8:00 AM AND 4:00 PM SATURDAY. NO CONSTRUCTION WORK ON SUNDAYS.
27. THE SITE ENCROACHES IN AREA OF FLOOD PLAIN ON FLOOD ZONE "X" BASED ON MAP NUMBER 1302000 EFFECTIVE ON MARCH 1.
28. THE SITE IS CURRENTLY A ZONED RESTRICTED INDUSTRIAL* WITHIN THE CITY OF DAWSONVILLE.
29. INTERIOR STREETS TO BE MAINTAINED PRIVATELY.
30. THE AREA OF LAND ENCROACHES INTO THE FLOOD ZONE "X" AREA. REFER TO SITE PLAN FOR THE FLOOD ZONE "X" AREA.



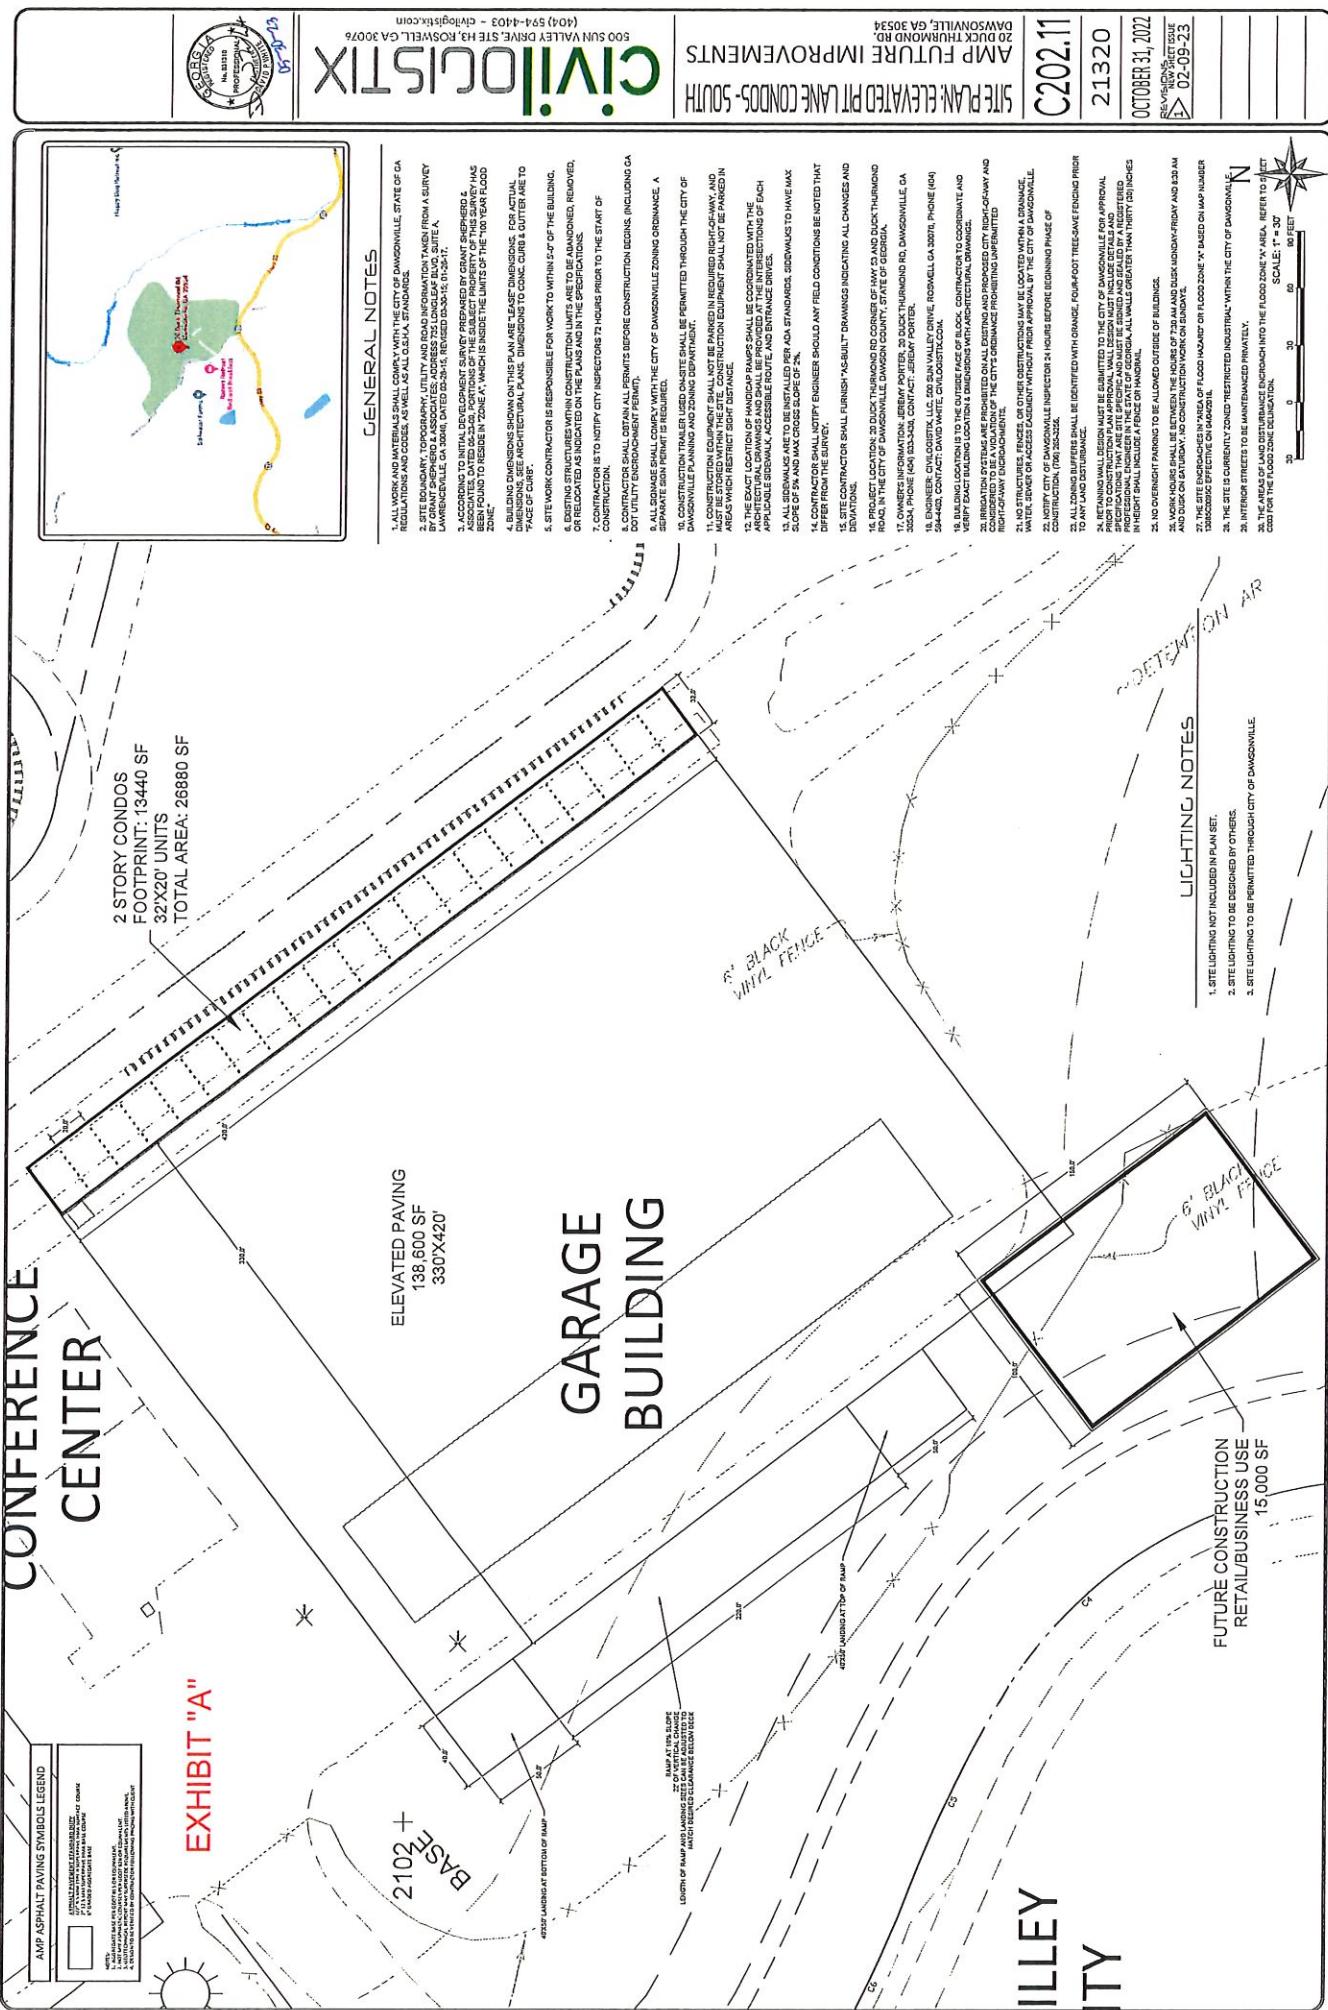

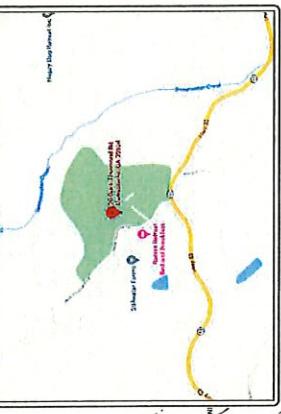

GENERAL NOTES

1. ALL WORK AND MATERIALS SHALL COMPLY WITH THE CITY OF GAINESVILLE, STATE OF GA. REGULATIONS AND CODES, AS WELL AS ALL G.S.A. STANDARDS.
2. SITE BOUNDARY, TOPOGRAPHIC, UTILITY AND ROAD INFORMATION TAKEN FROM A SURVEY BY GRANT SHEPHERD & ASSOCIATES, ADDRESS 725 LONGEVILLE BLVD, SUITE A, LAWNSVILLE, 30076, DATED 04-04-2013, REFERENCED DOCUMENTS, DRAWS.
3. ACCORDING TO INITIAL DEVELOPMENT SURVEY PREPARED BY GRANT SHEPHERD & ASSOCIATES, DATED 04-04-2013, THE PROPERTY OF THE SUBJECT PROPERTY IS LOCATED IN THE "LAWNSVILLE CREEK" ZONING DISTRICT, WHICH IS LOCATED IN THE TWO (2) "C-2" ZONE.
4. BUILDING DIMENSIONS SHOWN ON THIS PLAN ARE "LEASE" DIMENSIONS. FOR ACTUAL DIMENSIONS, SEE ARCHITECTURAL PLANS. DIMENSIONS 3'D TO CURB & GUTTER ARE TO FACE OF CURB.
5. SITE WORK CONTRACTOR IS RESPONSIBLE FOR WORK TO EXTEND 2' OF THE BUILDING. EXISTING STRUCTURES NOT ON CONSTRUCTION LISTS USE TO BE DEMOLISHED, RELOCATED, OR LOCATED AS INDICATED ON THE PLAN AND IN THE SPECIFICATIONS.
6. CONTRACTOR IS RESPONSIBLE FOR MAINTAINING THE SITE. CONSTRUCTION ENDS, CONTRACTOR IS TO NOTIFY CITY INSPECTORS 72 HOURS PRIOR TO THE START OF CONSTRUCTION.
7. CONTRACTOR IS TO NOTIFY CITY INSPECTORS 72 HOURS PRIOR TO THE START OF CONSTRUCTION.
8. CONTRACTORS SHALL MAINTAIN PERMITS BEFORE CONSTRUCTION BEGINS, INCLUDING GA DOT, UTILITY ENDROUGHT PERMIT, ETC.
9. ALL SWINGS SHALL COORDINATE WITH THE CITY OF GAINESVILLE ZONING ORDINANCE. A SWING PERMIT IS REQUIRED.
10. CONTRACTOR IS TO MAINTAIN THE SITE IN A NEAT AND CLEAN CONDITION. NO CONCRETE DEBRIS OR OTHER MATERIALS SHALL BE LEFT ON THE SITE.
11. CONTRACTOR IS TO MAINTAIN THE SITE IN A NEAT AND CLEAN CONDITION. NO CONCRETE DEBRIS OR OTHER MATERIALS SHALL BE LEFT ON THE SITE.
12. THE EXACT LOCATION OF THE INDIVIDUAL PAMPS SHALL BE COORDINATED WITH THE CONTRACTOR AND SHALL BE PROVIDED AT THE INTERSECTIONS OF DUCHESS, ARCADIA, SEDGWICK, ACCESS RROUTE, AND ENTRANCE DRIVES.
13. ALL SIDEWALKS ARE TO BE INSTALLED PER GA. STANDARDS. SIDEWALKS TO HAVE MAX SLOP OF 1% AND MAX CROSS SLOP OF 2%.
14. CONTRACTOR SHALL NOTIFY ENGINEER SHOULD ANY FIELD CONDITIONS BE NOTED THAT DIFFER FROM THE SURVEY.
15. SITE CONTRACTOR SHALL FURNISH "AS-BUILT" DRAWINGS INDICATING ALL CHANGES AND ADJUSTMENTS MADE TO THE SITE.
16. PROJECT LOCATION: 20 DUCK THURND RD CORNER OF HWY 29 AND DUCK THURND RD IN THE CITY OF GAINESVILLE, DAWSON COUNTY, STATE OF GEORGIA.
17. OWNER INFORMATION: JEREMY PORTER, 29 DUCK THURND RD, GAINESVILLE, GA, 30505, PHONE (404) 533-2420, CONTACT: JEREMY PORTER, 16 ENGINEER: CIVIC LOGISTICS, LLC, 520 SUN VALLEY DRIVE, ROSWELL, GA 30076, PHONE (404) 584-4440, CONTACT: DAVID WATTS, CIVIC LOGISTICS.COM.
18. BUILDING LOCATION IS TO THE OUTSIDE FACE OF BLOCK. CONTRACTOR TO COORDINATE AND VERIFY EACH BUILDING LOCATION IN BLOCKS WITH ARCHITECTURAL DRAWINGS.
19. IRIGATION SYSTEMS ARE PROHIBITED ON ALL DUSTING AND PROTECTED CITY RIGHT-OF-WAY AND CONTRACTOR IS TO VERIFY NO IRIGATION SYSTEMS ARE LOCATED ON THE PROPERTY.
20. IRIGATION SYSTEMS ARE PROHIBITED ON ALL DUSTING AND PROTECTED CITY RIGHT-OF-WAY AND CONTRACTOR IS TO VERIFY NO IRIGATION SYSTEMS ARE LOCATED ON THE PROPERTY.
21. ALL ZONING DIFFERENCES SHALL BE IDENTIFIED ON DRAWING.
22. NO OVERNIGHT PARKING TO BE ALLOWED OUTSIDE OF BUILDINGS.
23. NO WORKSHOPS SHALL BE BUILT IN THE HOURS OF 20 AM AND 05 MORNIG/FRIDAY AND 05 PM AND DUSK ON SATURDAY. NO CONSTRUCTION WORK ON SUNDAYS.
24. THE SITE ENCLOSED IS A 1/4 ACRE OF FLOOD ZONE "X" BASED ON MAP NUMBER 1820-1202-0000-0000-0000-0000.
25. THE SITE IS CURRENTLY ZONED RESTRICTED INDUSTRIAL" WITHIN THE CITY OF GAINESVILLE.
26. INTERIOR STREET TO BE MAINTAINED PRIVATELY.
27. THE AREA OF LAND SURFACE ENRICHMENT INTO THE FLOOD ZONE "X" AREA, REFER TO SELECT CODE FOR THE FLOOD ZONE DESIGNATION.

EXHIBIT "A"



ASPHALT PAVING SYMBOL LEGEND

1. SITE LIGHTING NOT INCLUDED IN PLAN SET.

2. SITE LIGHTING TO BE DESIGNED BY OTHERS.


3. SITE LIGHTING TO BE PERMITTED BY THE CITY OF GAINESVILLE.

2 STORY CONDOS
FOOTPRINT: 14720 SF
32'X20' UNITS
TOTAL AREA: 29440 SF

GARAGE BUILDINGS

ELEVATED PAVING
135,190 SF

2 LT LLC
NVILLE

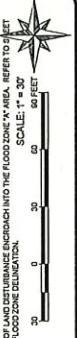

CONFERENCE CENTER

REVISIONS
OCTOBER 31, 2022

21320

C203.1


AMERICAN MUDFLAT SITE PLAN, GA 30076
DWYSONVILLE, GA 30534
DRAFT DATE: 05-23-2023
CIVIL LOGISTICS

SITE PLAN: GOLF-CART PATH
AMP FUTURE IMPROVEMENTS

(404) 594-4403 - CIVILLOGISTICS.COM



500 SUN VALLEY DRIVE, SUITE H, DAWSONVILLE, GA 30076

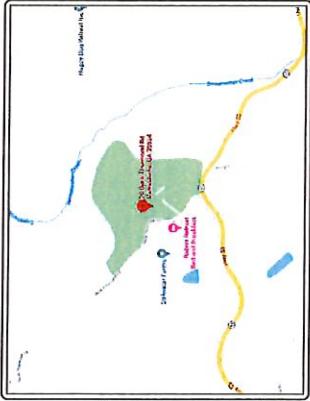

GENERAL NOTES

1. ALL WORK AND MATERIALS SHALL COMPLY WITH THE CITY OF DAWSONVILLE, STATE OF GA, BUILDING AND ZONING ORDINANCE, AS WELL AS ALL OTHER APPLICABLE LAWS.
2. THIS SURVEY IS FOR THE PURPOSE OF PROPERTY LINE LOCATION AND ROAD ALIGNMENT TAKEN FROM A SURVEY BY DAVIS SURVEYING CO., INC. ON BEHALF OF THE PROPERTY OWNER AND ROAD INVESTIGATOR, DATED 05-15-2023.
3. ACCORDING TO INITIAL DEVELOPMENT SURVEY PERFORMED BY GRANT, SURVEYOR & ASSOCIATES, DATED 05-24-2015, REVISED 05-15-2017.
4. A POINT HAS BEEN LOCATED ON THE SUBJECT PROPERTY OF THIS SURVEY AS BEING FOUND TO RESIDE IN "ZONE A," WHICH IS INSIDE THE LIMITS OF THE "100 YEAR FLOOD ZONE."
5. BUILDING DIMENSIONS SHOWN ON THESE PLANS ARE "LEAR" DIMENSIONS, FOR ACTUAL TRAILER OR CARAVAN, ADJUSTING TO CONCRETE CURB, GUTTER, ETC. TO THE FACE OF CURB.
6. SITE WORK CONTRACTOR IS RESPONSIBLE FOR WORK TO WITHIN 5'-0" OF THE BUILDING.
7. DESTROY STRUCTURES WITHIN CONSTRUCTION LIMITS ARE TO BE ABANDONED, REMOVED, OR RELOCATED AS INDICATED ON THE PLANS AND IN THE SPECIFICATIONS.
8. CONTRACTOR IS TO NOTIFY CITY INSPECTORS 72 HOURS PRIOR TO THE START OF CONSTRUCTION.
9. CONTRACTOR SHALL OBTAIN ALL PERMITS BEFORE CONSTRUCTION BEGINS, INCLUDING GA DOT UTILITY ENHANCEMENT PERMIT.
10. ALL SIGNAGE SHALL COMPLY WITH THE CITY OF DAWSONVILLE ZONING ORDINANCE, A SEPARATE SIGN PERMIT.
11. CONSTRUCTION TRAILER USED ON-SITE SHALL BE PERMITTED THROUGH THE CITY OF DAWSONVILLE PLANNING AND ZONING DEPARTMENT.
12. CONSTRUCTION EQUIPMENT SHALL NOT BE PARKED IN REQUIRED RIGHT-OF-WAY AND MUST BE STORED AWAY FROM THE SITE. CONSTRUCTION EQUIPMENT SHALL NOT BE PARKED IN ANY AREA WHERE IT CAN OBSTRUCT TRAFFIC.
13. THE POINT LOCATION OF THE HANDICAP RAMPS SHALL BE COORDINATED WITH THE APPLICABLE STORMWATER ACCESS ROUTE AND ENTRANCE DRIVES.
14. ALL SIDEWALKS ARE TO BE INSTALLED PER ADA STANDARDS. SIDEWALKS TO HAVE MAX SLOP OF 1% AND MAX CROSS SLOP OF 2%.
15. CONTRACTOR SHALL NOTIFY ENGINEER SHOULD ANY FIELD CONDITIONS BE NOTED THAT DIFFER FROM THE SURVEY.
16. SITE CONTRACTOR SHALL FURNISH P-A-S-U-L-T DRAWINGS INDICATING ALL CHANGES AND DIVISIONS.
17. PROJECT CONTRACTOR SHALL MAINTAIN THE PUBLIC PROPERTY OF DAWSONVILLE, GA, RIVER IN THE CITY OF DAWSONVILLE, DAWSONVILLE, GA, 30076 AND DAWSONVILLE ROAD IN THE CITY OF DAWSONVILLE, DAWSONVILLE, GA, 30076.
18. OWNER/DEVELOPER SHALL PROVIDE A DUST MITIGATION PLAN TO DAWSONVILLE, GA, 30076, PHONE 404-362-5424, CON-CECER, INC.
19. BUSINESS NAME: DAWSONVILLE, LLC, 200 SAVANNAH DRIVE, DAWSONVILLE, GA, 30076, PHONE 404-362-5424, CON-CECER, INC.
20. SITE CONTRACTOR SHALL NOT HAVE A TRADE SHOWCASE.
21. ALL CONSTRUCTION WORK SHALL BE IDENTIFIED WITH ORANGE, FOUR-FOOT TREE-SAVE FENCING PRIOR TO COMMENCEMENT OF WORK.
22. ALL CONSTRUCTION WORK SHALL BE IDENTIFIED WITH ORANGE, FOUR-FOOT TREE-SAVE FENCING PRIOR TO COMMENCEMENT OF WORK.
23. THE SITE DESIGN MAY BE SUBMITTED TO THE CITY OF DAWSONVILLE FOR APPROVAL. CONSTRUCTION DESIGN MAY BE SUBMITTED TO THE CITY OF DAWSONVILLE AND APPROVED BY THE CITY OF DAWSONVILLE, GA, 30076. DESIGNERS ARE TO USE SPECIFICATIONS AND STANDARDS AS PUBLISHED BY THE CITY OF DAWSONVILLE, GA, 30076.
24. NO STRUCTURES, FENCES, OR OTHER CONSTRUCTION MAY BE LOCATED WITHIN A DRAINAGE, WATER, SEWER OR ACCESS CHANNEL WHICH IS APPROVED BY THE CITY OF DAWSONVILLE, GA, 30076.
25. NO OVERNIGHT PARKING IS ALLOWED OUTSIDE OF BUILDINGS.
26. WORK HOURS SHALL BE BETWEEN THE HOURS OF 7:00 AM AND 4:00 PM MONDAY-FRIDAY AND 8:00 AM AND 4:00 PM SATURDAY. NO CONSTRUCTION WORK OR DAYLIGHT.
27. THE SITE ENCROACHES ON AREA OF FLOOD HAZARD OR FLOOD ZONE. X = BASED ON MAP NUMBER 261100.
28. THE SITE IS CURRENTLY ZONED RESTRICTED INDUSTRIAL WITHIN THE CITY OF DAWSONVILLE, GA, 30076.
29. INFERIOR STREETS TO BE MAINTAINED PRIVATELY.
30. THE AREA OF LAND DISTURBED INCORPORATED INTO THE FLOOD ZONE-X AREA, REFER TO MAP C203.1 FOR THE FLOOD ZONE DELIMITATION.

EXHIBIT "A"



MATCH LINE A
10.0'
12.0'
SAFETY FENCE
6.0'
6' BLACK VINYL FENCE


N
S
E
W
SCALE: 1" = 20'
20' 0' 20' 40' 60 FEET



CIVIL OCULISTS

SOO SU VALLEY DRIVE STE 30076
DASWONVILLE, GA 30503
AMC FUTURE IMPROVEMENTS
SITE PLAN: GOLF-CART PATH

(40) 591-1403 - Civilogistics.com

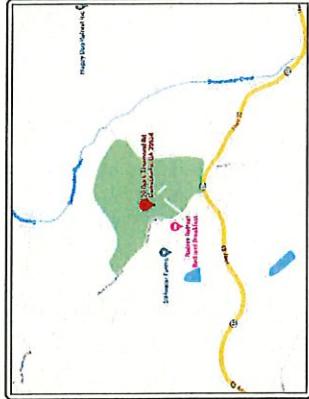

GENERAL NOTES

1. ALL WORK AND MATERIALS SHALL COMPLY WITH THE CITY OF DAWSONVILLE, STATE OF GA, ZONING, TOPOCARD, UTILITY AND ROAD INCIDENCE PLANS FROM A SURVEY BY GRANT SHEPHERD & ASSOCIATES, ADDRESS 725 LONGLEY BLVD, SUITE A, LAWRENCEVILLE, GA 30046, DATED 05-15, REVISED 05-15.
2. SITE BOUNDARY, TOPOGRAPHIC, UTILITY AND ROAD INCIDENCE PLANS FROM A SURVEY BY GRANT SHEPHERD & ASSOCIATES, ADDRESS 725 LONGLEY BLVD, SUITE A, LAWRENCEVILLE, GA 30046, DATED 05-15, REVISED 05-15.
3. ACCORDING TO INITIAL DEVELOPMENT SURVEY PREPARED BY GRANT SHEPHERD & ASSOCIATES, ADDRESS 725 LONGLEY BLVD, SUITE A, LAWRENCEVILLE, GA 30046, DATED 05-15, REVISED 05-15, THE SUBJECT PROPERTY OF THIS SURVEY HAS BEEN DIVIDED INTO TWO (2) PARCELS AS SHOWN ON THE "TWO (2) PARCELS" ZONE.
4. BUILDING DIMENSIONS SHOWN ON THIS PLAN ARE "LAKE DIMENSIONS". FOR ACTUAL BUILDING DIMENSIONS SEE ARCHITECTURAL PLANS. DIMENSIONS ARE TO GONE, CURB & GUTTER LINE TO FACE OF CART.
5. SITE OWNER CONTRACTOR IS RESPONSIBLE FOR WORK TO WITHIN 5'-0" OF THE BUILDING.
6. EXISTING STRUCTURES ALONG CONSTRUCTION LIMITS MUST BE ABANDONED, RELOCATED AS INDICATED ON THE PLANS AND IN THE SPECIFICATIONS.
7. CONTRACTOR IS TO NOTIFY CITY INSPECTOR 72 HOURS PRIOR TO THE START OF CONSTRUCTION.
8. CONTRACTOR SHALL OBTAIN ALL PERMITS BEFORE CONSTRUCTION BEGINS, INCLUDING GA DOT UTILITY ENHANCEMENT PERMIT.
9. SEPARATE SIGN PERMIT IS REQUIRED.
10. CONSTRUCTION THAT IS LOCATED ON SITE SHALL BE PERMITTED THROUGH THE CITY OF DAWSONVILLE PLANNING AND ZONING DEPARTMENT.
11. CONTRACTOR IS RESPONSIBLE FOR MAINTAINING THE SITE IN A NEAT AND Tidy CONDITION DURING CONSTRUCTION. NO TRASH OR WASTE MATERIALS SHALL BE STORED ON THE SITE. CONSTRUCTION DUST, DIRT, DIRT PILE AND TRASH SHALL NOT BE STORED IN AREA WHICH RESTRICTS SITE DISTANCE.
12. THE EXACT LOCATION OF HANDICAP RAMPS SHALL BE COORDINATED WITH THE ARCHITECTURAL DRAWINGS AND SHALL BE PROVIDED AT THE INTERSECTION OF SUCH ACCESSIBLE SIDEWALK, ACCESSIBLE ROUTE, AND ENTRANCE DRIVES.
13. ALL SIDEWALKS SHALL COORDINATE WITH THE CITY OF DAWSONVILLE ZONING ORDINANCE.
14. CONTRACTOR SHALL NOTIFY ENGINEER SHOULD ANY FIELD CONDITIONS DE NOTE THAT DIFFER FROM THE SURVEY.
15. SITE CONTRACTOR SHALL FURNISH "AS-BUILT" DRAWINGS INDICATING ALL CHANGES AND ADJUSTMENTS MADE DURING CONSTRUCTION.
16. PRODUCT LOCATION: 20 DUCK THURGOOD RD CORNER OF HWY 29 AND DUCK THURGOOD ROAD IN THE CITY OF DAWSONVILLE, DAWSONVILLE, STATE OF GEORGIA.
17. OWNER INFORMATION: JEFFREY PORTER, 29 DUCK THURGOOD RD, DAWSONVILLE, GA, 30533, PHONE (404) 632-3429, CONTACT: JEFFREY PORTER, 29 DUCK THURGOOD RD, DAWSONVILLE, GA, 30533, CONTACT: DAVID WATKINS, CIVILOGISTICS, LLC, 100 SUN VALLEY DRIVE, ROME, GA 30166, PHONE (404) 564-4440.
18. BUILDING LOCATION IS TO THE EXTERIOR FACE OF BLOCK. CONTRACTOR TO COORDINATE AND VERIFY EACH BUILDING LOCATION WITH ARCHITECTURAL DRAWINGS.
19. IRIGATION SYSTEMS ARE PROHIBITED ON ALL DRIVES AND PROTECTED CITY RIGHT-OF-WAY AND SIDEWALKS.
20. RETAINING WALLS ARE TO BE MAINTAINED UNPUNCHED AND UNCOATED. NO PAINT, NO STAIN, NO ACCESS TO RETAINING WALLS.
21. RETAINING WALL DESIGN AND CONSTRUCTION SHALL BE SUBMITTED TO THE CITY OF DAWSONVILLE, DAWSONVILLE PLANNING AND ZONING DEPARTMENT FOR APPROVAL. NO PERSONAL EQUIPMENT FROM THE STATE OF GEORGIA, ALL WALLS GREATER THAN 48 INCHES IN HEIGHT SHALL INCLUDE A FENCE OR FENCELINE.
22. NO OVERNIGHT CARING TO BE ALLOWED OUTSIDE OF BUILDINGS.
23. WORK HOURS SHALL BE BETWEEN THE HOURS OF 7:00 AM AND 7:00 PM, MONDAY-FRIDAY AND 10:00 AM AND 4:00 PM SATURDAY. NO CONSTRUCTION WORK ON SUNDAYS.
24. THE SITE ENDROPS IN THE AREA OF FLOOD HAZARD ON FLOOD ZONE "X" BASED ON MAP NUMBER 18200. ENDROPS EFFECTIVE ON OVERCAST.
25. THE SITE IS CURRENTLY ZONED "RESTRICTED INDUSTRIAL" WITHIN THE CITY OF DAWSONVILLE.
26. INTERNAL STREETS TO BE MAINTENANCE PRIVATE.
27. THE AREA OF LAND DISTURBANCE ENCROACHES INTO THE FLOOD ZONE "X" AREA. REFER TO SITE PLAN FOR THE LOCATION OF THE FLOOD ZONE "X" AREA.




C203.2

213120
OCTOBER 31, 2022
REVISIONS

EXHIBIT "A"

AMP ASPHALT PAVING SYMBOLS LEGEND	
[Symbol: White square with black border]	Asphalt Pavement
[Symbol: White square with black border, dashed lines]	Asphalt Pavement with drainage
[Symbol: White square with black border, diagonal lines]	Asphalt Pavement with drainage
[Symbol: White square with black border, diagonal lines]	Asphalt Pavement with drainage

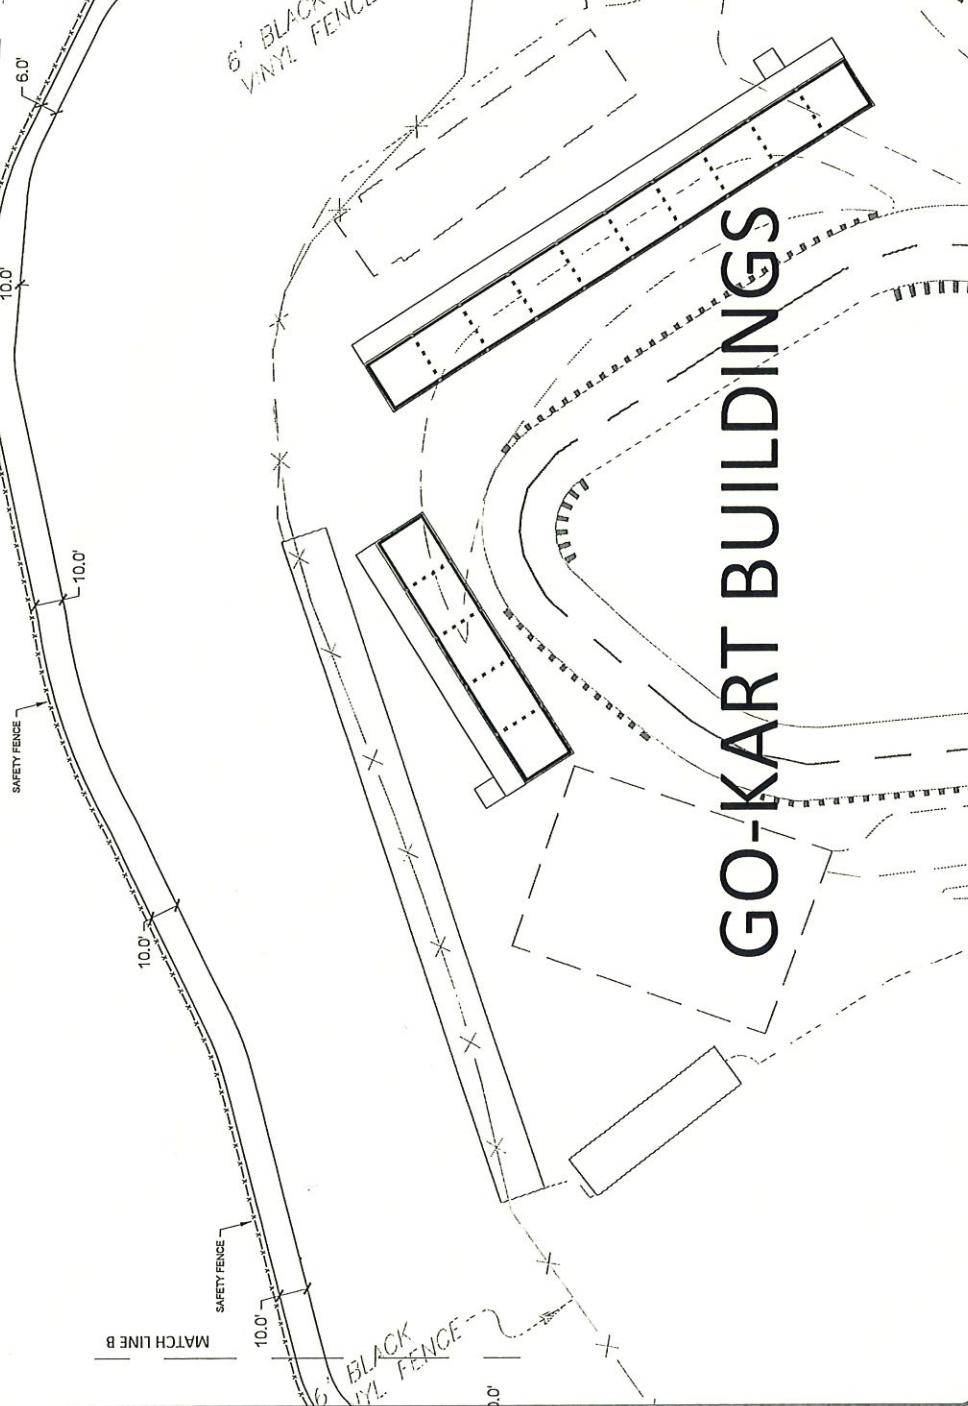




05-13



EXHIBIT "A"

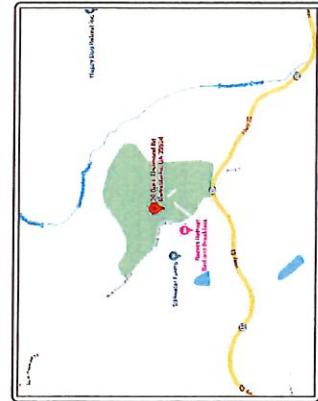

GENERAL NOTES

1. ALL WORK AND MATERIALS SHALL COMPLY WITH THE CITY OF DAWSONVILLE, STATE OF GA REGULATIONS AND CODES AS WELL AS ALL STATE STANDARDS.
2. SITE BOUNDARY, TOPOGRAPHIC, UTILITY AND ROAD INFORMATION TAKEN FROM A SURVEY LIAISONVILLE, GA 30456 DATED OCT 2014, REVISED TO DATE 05-13-2022.
3. ACCORDING TO INITIAL DEVELOPMENT SURVEY PERFORMED BY ASSOCIATES, DATED 05-13-2022, PORTION OF THE SUBJECT PROPERTY OF THIS SURVEY HAS BEEN FOUND TO RESIDE IN ZONE A, WHICH IS INSIDE THE LIMITS OF THE "100 YEAR FLOOD ZONE".
4. BUILDING DIMENSIONS SHOWN ON THESE PLANS ARE "LEAGUE" DIMENSIONS. FOR ACTUAL USE, CONTRACTOR IS RESPONSIBLE FOR WORK TO WITHIN +/- 5' OF THE BUILDING.
5. EXISTING STRUCTURES WITHIN CONSTRUCTION LIMITS ARE TO BE ABANDONED, REMOVED, OR RELOCATED AS INDICATED ON THE PLANS AND IN THE SPECIFICATIONS.
6. CONTRACTOR IS TO NOTIFY CITY INSPECTORS 72 HOURS PRIOR TO THE START OF CONSTRUCTION.
7. CONTRACTOR SHALL OBTAIN ALL PERMITS BEFORE CONSTRUCTION BEGINS, INCLUDING GA DOT UTILITY ENCROACHMENT PERMIT.
8. ALL SURVEYS SHALL COPY WITH THE CITY OF DAWSONVILLE ZONING ORDINANCE. A SEPARATE SURVEY IS REQUIRED.
9. CONSTRUCTION TRAILER USED ON-SITE SHALL BE PERMITTED THROUGH THE CITY OF DAWSONVILLE PLANNING AND ZONING DEPARTMENT.
10. CONSTRUCTION EQUIPMENT SHALL NOT BE PARKED IN REQUIRED RIGHT-OF-WAY, AND MUST BE STORED OUTSIDE THE SITE. CONSTRUCTION EQUIPMENT SHALL NOT BE PARKED IN ANY PUBLIC HIGHWAY NEARBY.
11. THE EXACT LOCATION OF HANDICAP RAMPS SHALL BE COORDINATED WITH THE APPROPRIATE HIGHWAY AUTHORITY. CONTRACTOR IS RESPONSIBLE FOR THE INSTALLATION OF SUCH RAMPS.
12. ALL EGRESS IS TO BE PROVIDED BY THE CONTRACTOR. CONTRACTOR IS RESPONSIBLE FOR MAINTAINING ALL EGRESS ROADS AND STREETS.
13. CONTRACTOR & CONSULTANT ENGINEER SHOULD ANY FIELD CONDITIONS BE NOTED THAT DIFFER FROM THE SURVEY.
14. SITE CONTRACTOR SHALL FURNISH "AS-BUILT" DRAWINGS INDICATING ALL CHANGES AND ADJUSTMENTS MADE TO BLOCK THE BOUNDARIES OF HIGHWAYS AND DUSCHURMOND ROAD.
15. CONTRACTOR SHALL NOTIFY THE CITY OF DAWSONVILLE OF THE BOUNDARIES OF HIGHWAYS AND DUSCHURMOND ROAD.
16. CONTRACTOR SHALL NOTIFY THE CITY OF DAWSONVILLE OF THE BOUNDARIES OF HIGHWAYS AND DUSCHURMOND ROAD.
17. CONTRACTOR SHALL NOTIFY THE CITY OF DAWSONVILLE OF THE BOUNDARIES OF HIGHWAYS AND DUSCHURMOND ROAD.
18. CONTRACTOR SHALL NOTIFY THE CITY OF DAWSONVILLE OF THE BOUNDARIES OF HIGHWAYS AND DUSCHURMOND ROAD.
19. CONTRACTOR SHALL NOTIFY THE CITY OF DAWSONVILLE OF THE BOUNDARIES OF HIGHWAYS AND DUSCHURMOND ROAD.
20. CONTRACTOR SHALL NOTIFY THE CITY OF DAWSONVILLE OF THE BOUNDARIES OF HIGHWAYS AND DUSCHURMOND ROAD.
21. CONTRACTOR SHALL NOTIFY THE CITY OF DAWSONVILLE OF THE BOUNDARIES OF HIGHWAYS AND DUSCHURMOND ROAD.
22. NO STRUCTURES, FENCES OR OTHER ENCLOSURE MAY BE LOCATED WITHIN A DRAINAGE, WATER, SEWER OR ACCESS EASEMENT APPROVED BY THE CITY OF DAWSONVILLE.
23. NOTIFY CITY OF DAWSONVILLE INSPECTOR 24 HOURS BEFORE BEGINNING PHASE II CONSTRUCTION. (TODAY).
24. ALONGNO FENCE LINES SHALL BE IDENTIFIED WITH ORANGE, FOUR-FOOT TREES-FAWN FENCE PINE TO ATTACH TO EXISTING FENCE LINES.
25. RETROFIT WALL DESIGN MATURED AND SUBMITTED TO THE CITY OF DAWSONVILLE FOR APPROVAL, DETERMINING THAT ARE EAT SPECIFIC AND MUST BE GRANTED AND CALLED FOR REGISTERED PROFESSIONAL, LICENSED IN THE STATE OF GEORGIA. ALL WALLS GREATER THAN THIRTY (30) INCHES IN HEIGHT SHALL BE ENTHUSED.
26. NO OVERHANG FENCING TO ALLOW OUTSIDE OF BUILDINGS.
27. WORKING SHALL BE KEPT WITHIN THE ROAD OF 210 MAIN AND DUSCH, MONDAY-FRIDAY AND 8:30 AM AND 5:00 PM.
28. THE SITE ENCROACHES ON A PORTION OF FLOOD PLAIN OR FLOOD ZONE X BASED ON MAP NUMBER 21320.
29. THE SITE IS CURRENTLY ZONED RESTRICTED INDUSTRIAL WITHIN THE CITY OF DAWSONVILLE.
30. INTERIOR STREETS TO BE MAINTAINED PRIVATELY.
31. NO AREA OF LAND SURFACE INCIDING INTO THE FLOOD ZONE AREA, REFER TO MAP NUMBER 21320 FOR THE FLOOD ZONE DELIMITED.

50' UNDISTURBED
STATE BUFFER






CIVIL OLSIX

SOO SUN VALLEY DRIVE, STE. H3, ROSWELL, GA 30076
(404) 594-1403 CH 30076

C203.4
21320
OCTOBER 31, 2022
REVISIORS

AMP FUTURE IMPROVEMENTS
SITE PLAN, GOLF CART PATH
20 DUCK THURMUND RD.

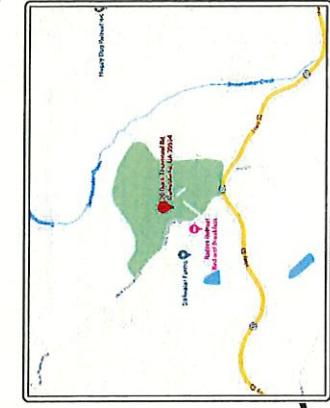

GENERAL NOTES

- ALL WORK AND MATERIALS SHALL COMPLY WITH THE CITY OF DAWSONVILLE, STATE OF GA. REGULATIONS AND CODES, AS WELL AS ALL OSHA STANDARDS.
- SITE SURVEY, TOPOGRAPHY, UTILITY, AND ROAD INFORMATION TAKEN FROM A SURVEY BY GRANT SHEPHERD ASSOCIATES, ADDRESS 755 LONGFORD LAKE SUITE A, LAWNSVILLE, GA, LOCATED 300-54-1, REVISED 10-25-14.
- INITIAL DEVELOPMENT SURVEY PREPARED BY GRANT SHEPHERD & ASSOCIATES, ADDRESS 755 LONGFORD LAKE SUITE A, LAWNSVILLE, GA, REVISED 10-25-14.
- CONTRACTOR IS RESPONSIBLE FOR MAINTAINING PROPERTY OWNED BY THE CITY OF DAWSONVILLE, OR ITS AGENTS, CONTRACTORS, OR SUBCONTRACTORS, AT A COST NOT TO EXCEED 1% OF THE TOTAL COST OF THE PROJECT.
- BUILDING DIMENSIONS SHOWN ON THIS PLAN ARE IN FEET. OTHER DIMENSIONS, FOR ACTUAL DIMENSIONS, SEE ARCHITECTURAL PLANS.
- ALL SIDWALKS ARE TO BE CONCRETE. CUBIC & GUTTER ARE TO FACE OF CURB.
- SITE WORK CONTRACTOR IS RESPONSIBLE FOR WORK TO MTRN 50' OF THE BUILDING.
- EXISTING STRUCTURES WHICH CONSTRUCTION LISTS ARE TO BE ABANDONED, REMOVED, OR RELOCATED AS INDICATED ON THE PLANS AND IN THE SPECIFICATIONS.
- CONTRACTOR IS TO NOTIFY CITY INSPECTORS 72 HOURS PRIOR TO THE START OF CONSTRUCTION.
- CONTRACTOR SHALL OBTAIN ALL PERMITS BEFORE CONSTRUCTION BEGINS, INCLUDING DA, UTILITY ENRICHAMENT PERMIT.
- ALL SIGNS SHALL COMPLY WITH THE CITY OF DAWSONVILLE ZONING ORDINANCE. A SITE WORK SIGN PERMIT IS REQUIRED.
- DA, CONSTRUCTION, AND LAND USE DEPARTMENT SHALL BE APPRISED THROUGH THE CITY OF DAWSONVILLE PLANNING AND ZONING DEPARTMENT.
- LA, THE CONTRACTOR IS RESPONSIBLE FOR MAINTAINING THE SITE, CONSTRUCTION EQUIPMENT, AND MATERIALS IN A PROFESSIONAL MANNER. THIS SHALL NOT BE PAGED IN AREA WHICH RESTRICT SITE OF DISTANCE.
- THE EXACT LOCATION OF HANDICAP RAMPS SHALL BE COORDINATED WITH THE ARCHITECTURAL DRAWINGS AND SHALL BE PROVIDED AT THE INTERSECTIONS OF EACH APPLICABLE SIDEWALK, ACCESSIBLE CURVE, AND ENTRANCE DRIVES.
- ALL SIDEWALKS ARE TO BE INSTALLED PER ADA STANDARDS. SIDEWALKS TO HAVE MAX SLOPE OF 1% AND MAXIMUM ROLL-OFF OF 1%.
- CONTRACTOR SHALL NOTIFY ENGINEER SHOULD ANY FIELD CONDITIONS BE NOTED THAT DIFFER FROM THE SURVEY.
- CONTRACTOR SHALL FURNISH "AS-BUILT" DRAWINGS INDICATING ALL CHANGES AND DEVIATIONS.
- PRODUCT LOCATION IS DUCK THURMUND RD CORNER OF HWY 25 AND DUCK THURMUND ROAD, IN THE CITY OF DAWSONVILLE, DAWSON COUNTY, STATE OF GEORGIA.
- OWNER INFORMATION: BRADY PORTER, 20 DUCK THURMUND RD, DAWSONVILLE, GA 30536, PHONE: (404) 633-5439, CONTACT: SEBASTIAN PORTER.
- ENGINEER: CIRCOOLIS, LLC, 320 SUN VALLEY DRIVE, ROSWELL, GA 30076, PHONE: (404) 564-4200, CONTACT: DAVID WHITE, CIRCOOLIS, LLC.
- BUILDING LOCATION IS TO THE OUTSIDE FACE OF BLOCK. CONTRACTOR TO COORDINATE AND VERIFY EXISTING LOCATION AROUND A BURDEN WITH ARCHITECTURAL DRAWINGS.
- IRRIGATION SYSTEMS ARE PROHIBITED ON CITY RIGHT-OF-WAY AND PROHIBITED ON PROPERTY OWNED BY THE CONTRACTOR. IRIGATION IS PROHIBITED ON THE PROPERTY OWNED BY THE CONTRACTOR.
- NO TRASH OR CONSTRUCTION WASTE IS TO BE LEFT ON THE PROPERTY OWNED BY THE CONTRACTOR.
- CONTRACTOR IS RESPONSIBLE FOR MAINTAINING THE SITE, CONSTRUCTION EQUIPMENT, AND MATERIALS IN A PROFESSIONAL MANNER. THIS SHALL NOT BE PAGED IN AREA WHICH RESTRICT SITE OF DISTANCE.
- LANDSCAPE SURFACE SHALL BE IDENTIFIED WITH GRANGE, FOUR-FOOT TIMECALE ENDING PRIOR TO ANY LAND DISTURBANCE.
- REFINISH WALL DESIGN MUST BE SUBMITTED TO THE CITY OF DAWSONVILLE FOR APPROVAL. WALL DESIGN MUST INCLUDE DETAILS AND DRAWINGS AS TO THE TYPE OF FINISH, COLOR, AND FINISH. THE CONTRACTOR IS RESPONSIBLE FOR PREPARATION OF THE FINISH. THE CONTRACTOR IS RESPONSIBLE FOR THE FINISHING OF THE WALL. THE CONTRACTOR IS RESPONSIBLE FOR THE FINISHING OF THE WALL.
- NO OVERNIGHT PARKING TO BE ALLOWED OUTSIDE OF BUILDINGS.
- WORK HOURS SHALL BE BETWEEN THE HOURS OF 7:00 AM AND DUCK THURMUND ROAD AND 6:00 PM AND DUCK THURMUND ROAD.
- NO DUST OR SMOKE IS TO BE RELEASED ON THE PROPERTY OWNED BY THE CONTRACTOR.
- THE SITE ENTHOUGHTS IN AREA OF FLOOD HAZARD OR FLOOD ZONE "X" BASED ON MAP NUMBER FLOODZONE EFFECTIVE ON OCTOBER 1, 2022.
- INTERIOR STREETS TO BE MAINTAINED PRIVATELY.
- THE AREA OF LAND DISTURBANCE ENTRANCE INTO THE FLOOD ZONE "X" AREA, REFER TO SITE PLAN FOR THE CROSS SECTION DRAWINGS.


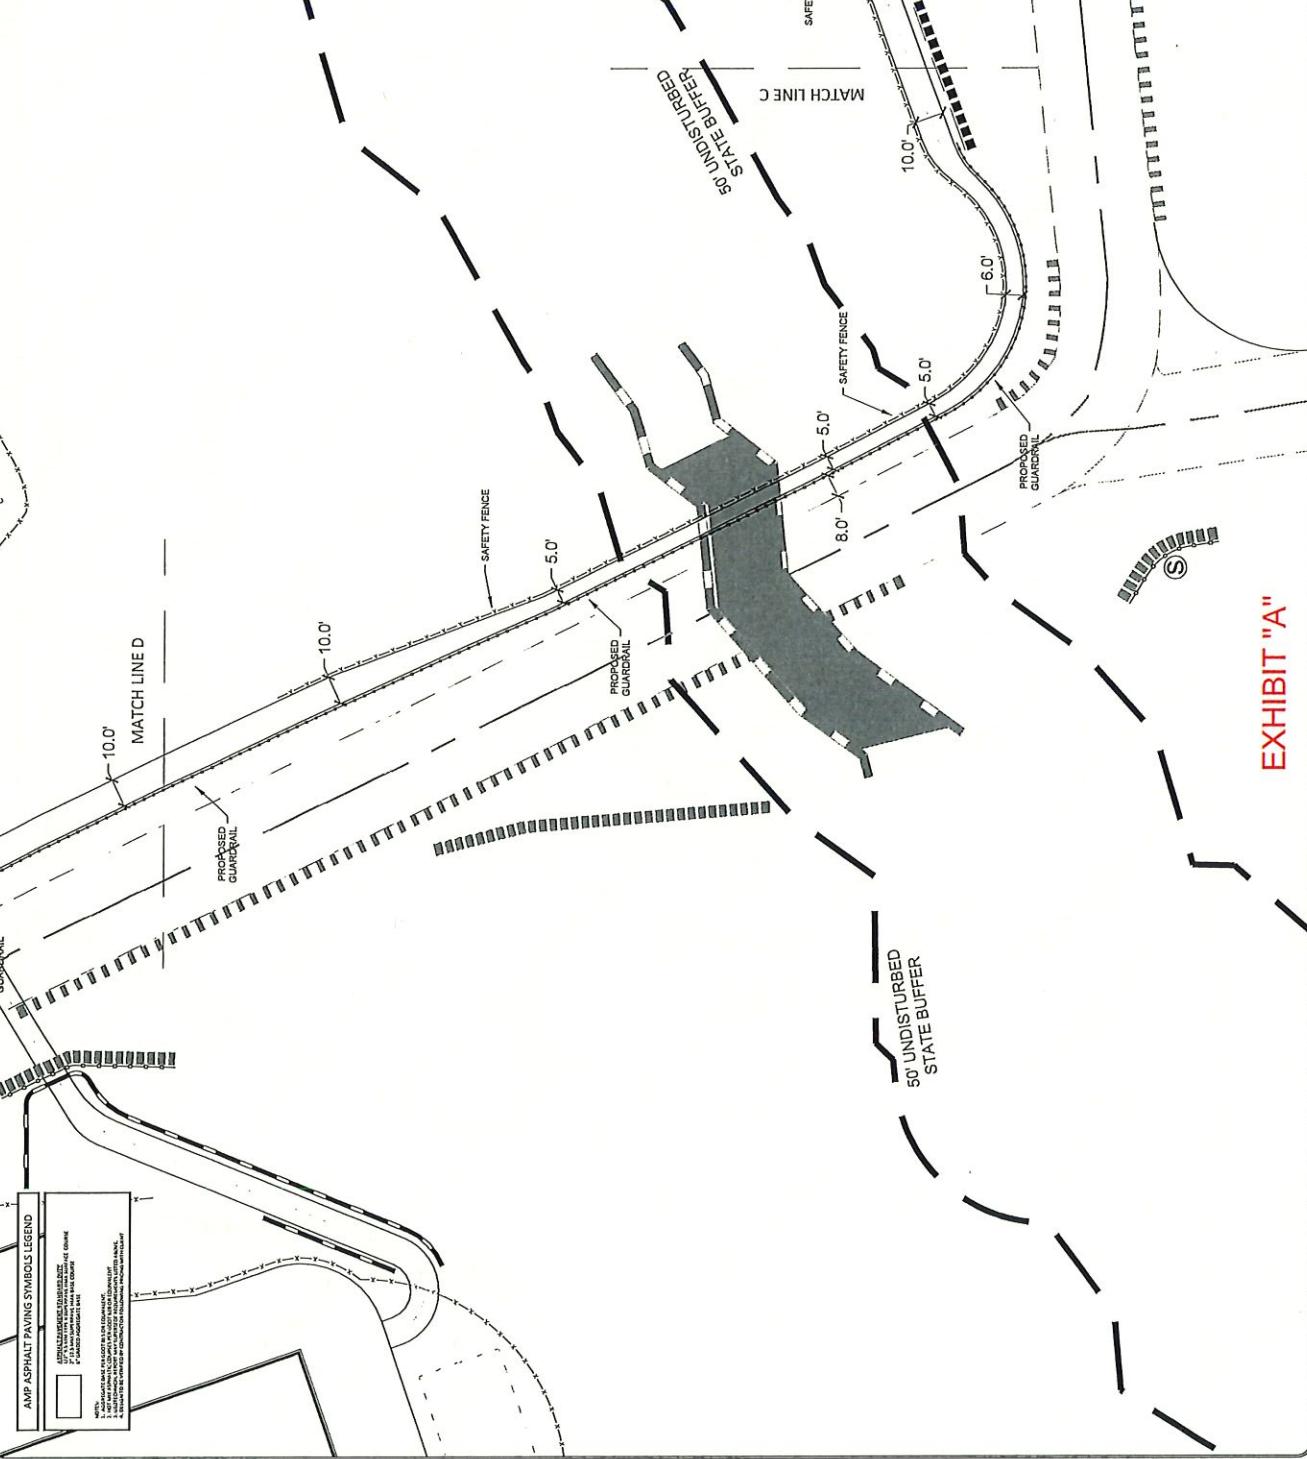


EXHIBIT "A"



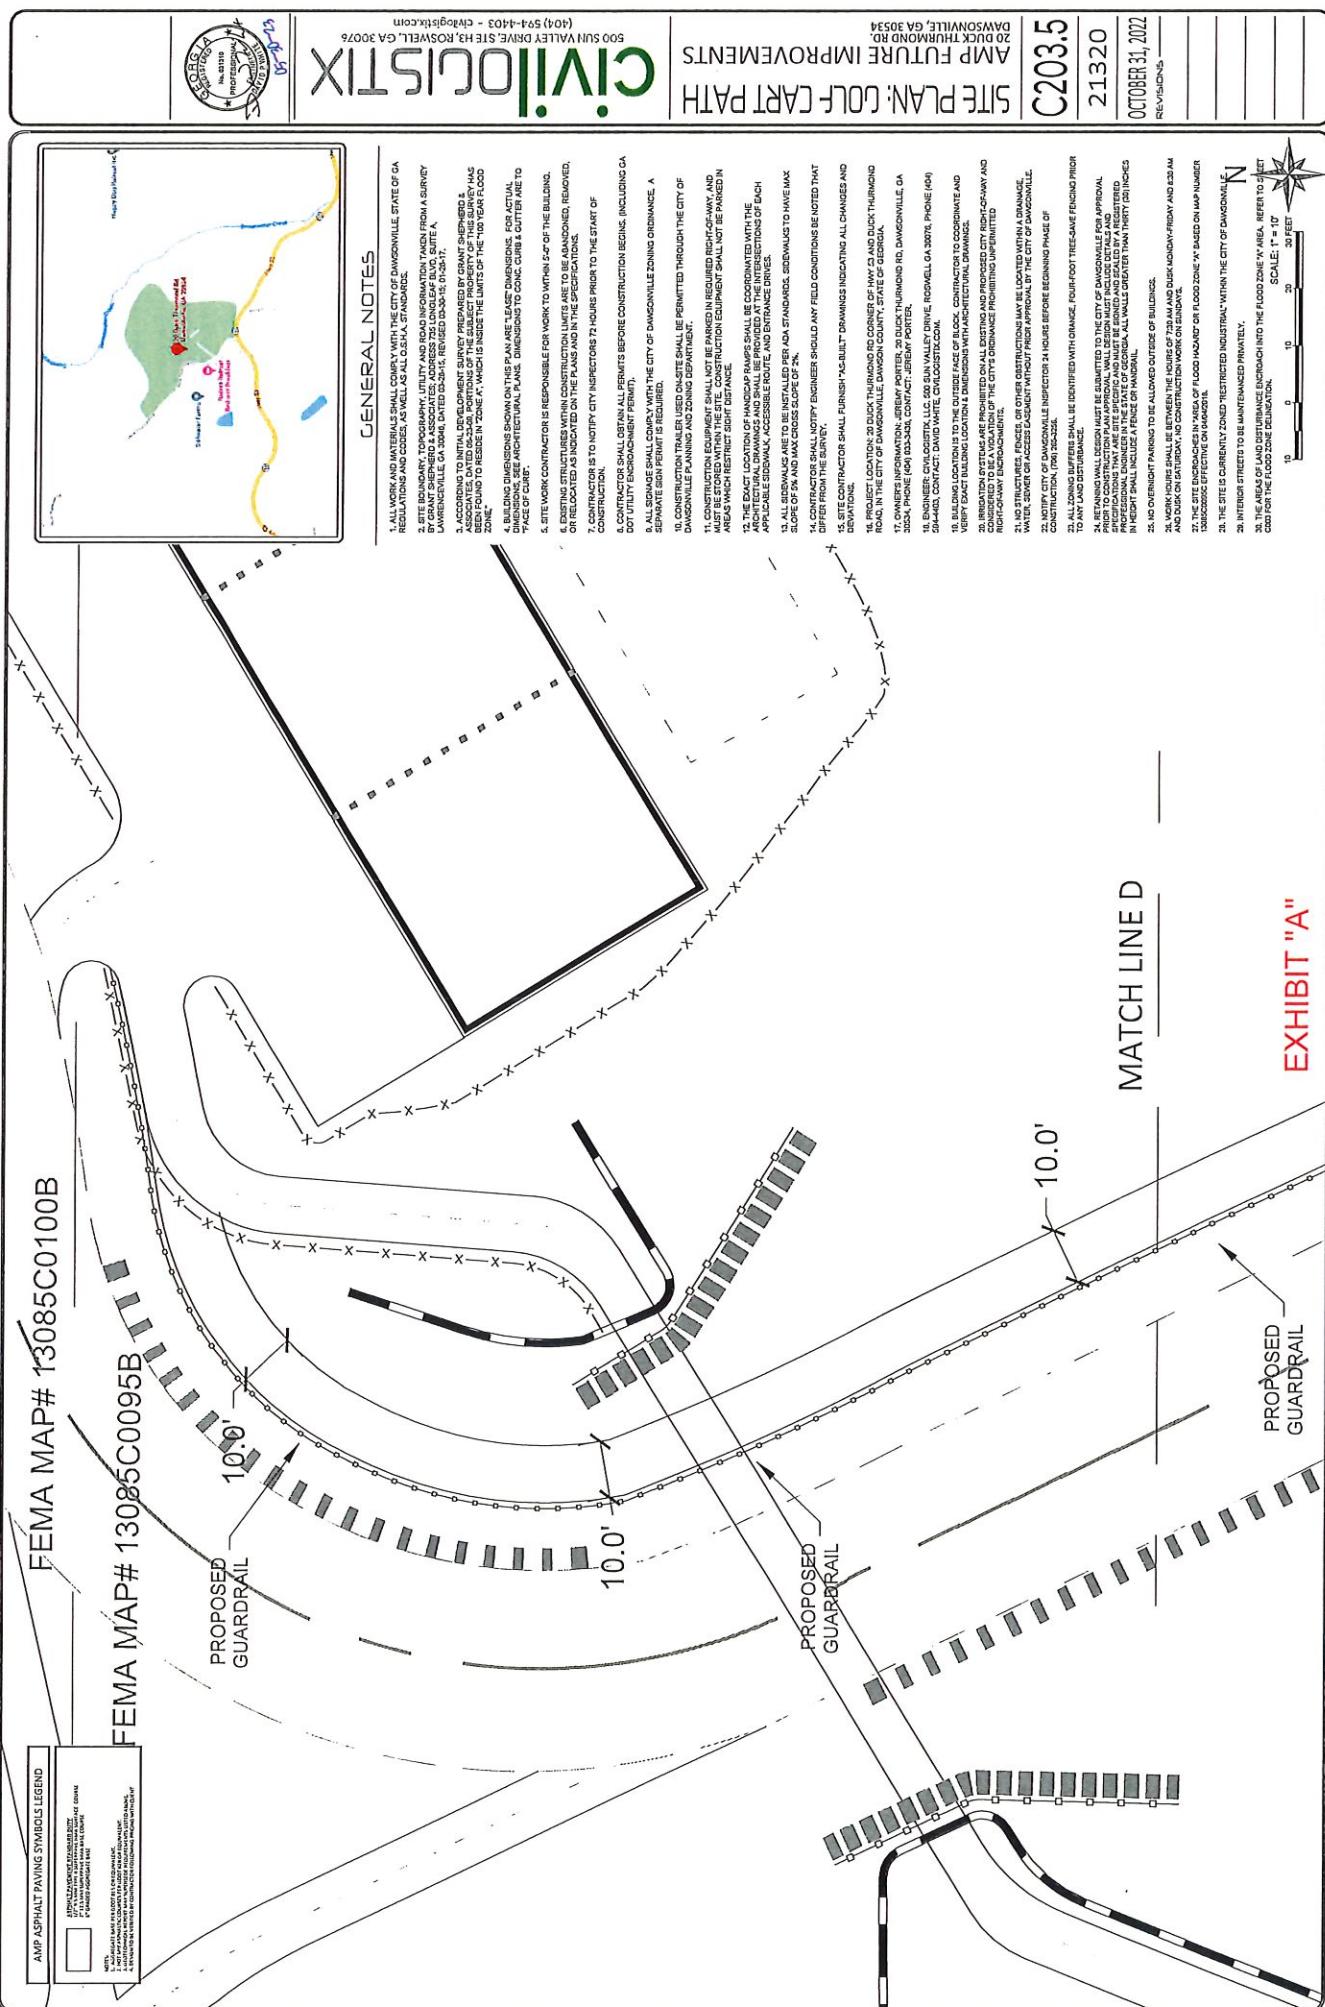


FINAL PLAT OF SILVER LEAF TOWNHOMES

CLERK OF THE COURT FILING INFORMATION

NOTES:

1. Land Owner: Chapman Precision - 17111522, Angelia Enro - PSTA.
2. Map: Plat Drawing, Plan with a Lot(s) TSd on 5-6-2019 & 11-1-2022 and were balanced using the Compass Rule.
3. Bearings, elevations and coordinates are based on Grid North, GA West Zone, NAVD 88 and established with a class GPS using the SmartNet GPS.
4. Plat Drawing: 17111522, dated 11-1-2022.
5. The boundaries of the property are delineated by the surveyor's monuments, boundaries, corners, boundaries, easements, and distance to the state line if not and is not intended to contribute to a site search or title opinion.
6. Portion of the property is located in a Flood Hazard Area as indicated on F.I.R.M. No. 1398200111C-130820059C, dated 4-4-2018.
7. Front = 27'-0"; Back = 82'-0"; Side = 9'-0".
8. Exterior Buffer = 10'
9. Lot and Unit Widths (Townhomes) = 29'-25' Min.
10. Minimum Seams Width = 1200"
11. Maximum Building Height = 35'
12. Total Subdivision Area = 9.16 Ac.
13. Density = 430/28.5 = 15.19 bph/ac.
14. Lot Number = 43004.
15. Lot Number = 43004.
16. Construction of lots will be limited to one dwelling unit per lot.
17. Construction of lots will be limited to one dwelling unit per lot.
18. Construction of lots will be limited to one dwelling unit per lot.
19. Construction of lots will be limited to one dwelling unit per lot.
20. Construction of lots will be limited to one dwelling unit per lot.
21. Construction of lots will be limited to one dwelling unit per lot.
22. Sanitary Sewer access to City of Dawsonville, Water and Sewer.
23. The developer/contractor is responsible for maintenance and utility/feathering of all water and sewer infrastructure until maintenance bond is released.

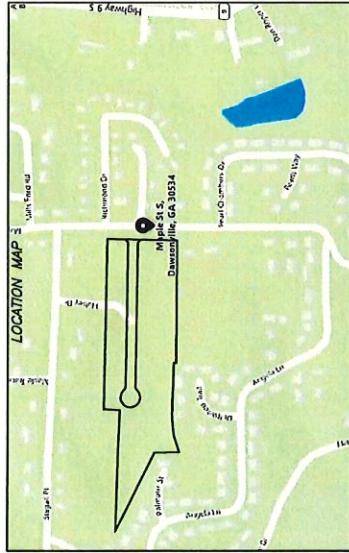

Land Lots 446 & 447, 4th District, 1st Section
City of Dawsonville, Dawson County, Georgia

SHEET INDEX
1 COVER SHEET
2 ZONING CONDITIONS
3 FINAL PLAT
4 SUBDIVISION AGREEMENT
5 FINAL PLAT
6 AS BUILT
7 STORMWATER PONDS

OWNERS ACKNOWLEDGEMENT

This is to certify that the undersigned, the owner(s) of the property described in this plat, have read and understood the terms and conditions contained in the Final Plat and the accompanying documents and that this plat was made from an as-built survey, and dedications by this Declarant to use of the public streets, rights-of-way, sanitary sewer and stormwater systems, sanitary sewer easements, possible water easements, possible water rights, and other interests in the property, which are described in the Final Plat and the accompanying documents, and that the undersigned has read and understood the terms and conditions contained therein for the purposes herein expressed.

M. McWhorter

Signature

6/28/2023 Date:

Engineer's As-Built Certification
Entity Name: I, the engineer/holder of the storm drainage system will function as designed and engineered in the approved construction drawings. I, the engineer/holder of the storm drainage system will provide the storage of volumes of water generated by the storm drainage system and its sanitary sewer hydraulics study, and as in the water distribution system and/or sanitary sewer system updated by me this As-Built Drawing was constructed in accordance with the plans approved by the City of Dawsonville. The information submitted on this As-Built Drawing is to the best of my knowledge and belief, true and accurate to my knowledge.

M. McWhorter

Signature

5-23-2023 Date:

PLANNING COMMISSION & CITY APPROVAL
This plat has been reviewed and approved by the Planning Commission and the City Council, and is subject to the requirements of the Zoning Ordinance, Development Regulations and Subdivision Regulations. The Mayor and City Council hereby approve this Final Plat, subject to the provisions and requirements of the City's regulations.

Mayor: _____ Date: _____

City Engineer: _____ Date: _____

McWhorter & Anderson
LAND SURVEYING &
CIVIL ENGINEERING
416 PIRKLE FERRY ROAD
BUILDING H, UNIT 300
CUMMING, GEORGIA 30040
PHONE: (770) 889-9430

OWNER / PRIMARY PERMITTEE:
885 LINC PROPERTIES, LLC
885 BROADWOOD DR, SUITE 305
ROCKDALE, GA 30075
REG'D (470) 232-8096
24 HOUR CONTACT:
MR. MOSTAFA ALAHY
(470) 232-8096

EXHIBIT "B"

LOT	LOT NO.	LOT SQ. FEET	LOT NO.	LOT SQ. FEET
1	43004	23,400.04	2	5,006
2	43006	24,298.44	3	3,098
3	43007	25,298.44	4	3,694
4	43008	26,400.04	5	3,918
5	43009	27,400.04	6	4,652
6	43010	29,593	7	4,668
7	43011	31,593	8	3,110
8	43012	32,400.04	9	3,110
9	43013	33,298.53	10	3,115
10	43014	34,298.44	11	3,119
11	43015	35,298.44	12	4,191
12	43016	34,298.44	13	4,197
13	43017	35,298.44	14	3,131
14	43018	36,298.44	15	3,135
15	43019	37,400.04	16	3,138
16	43020	38,298.44	17	3,438
17	43021	39,298.33	18	4,222
18	43022	40,298.44	19	3,522
19	43023	42,298.53	20	3,559
20	43024	43,161	21	4,422



11-11-2022
Neil A. McWhorter GSRLS # 2844
Date
L.S.P. #LS00275
K.E.O., Inc. Certificate of Authorization Number: LS00275

MINUTES
CITY COUNCIL REGULAR MEETING
OCTOBER 1, 2007
7:00 P.M.

CALL THE MEETING TO ORDER: Mayor Cox called the meeting to order at 7:00 p.m.

ROLL CALL: Those present included Mayor Cox, Lee Anne Miller, Council Member Linda Grant, Mike Seaborn, and Jonathan Cox. Also present were Kim Comerford, Steve Holder, Gary Barr, and Diana Pyle, City Attorney.

INVOCATION AND PLEDGE: Invocation was led by Steve Holder; Mayor Cox led the pledge of allegiance.

APPROVAL OF MINUTES:

Council unanimously approved the minutes from the regular meeting held September 10, 2007; motion by Seaborn, second by Cox.

NEW BUSINESS:

Establishment of Doghouse Outfitter as a National Dogcare Subsidized Assistance Model: The Shelt Family Awareness Month. It was presented by Mayor Cox after it had been voted by Kim Comerford.

Danielle Shelt, National Doghouse: More for Kids Animal Mammals Marathon Festival, October 26, 27, 2007, at the Doghouse. It was presented by Mayor Cox after it had been voted by Kim Comerford.

Sheriff's office, the Fire Marshal, and the Dept. of Transportation. Council unanimously approved the application motion by Linda Grant, second by Jonathan Cox.

OLD BUSINESS:

Zoning Adjustment ZA-2007-055: Avery Homes Inc. has made application to amend the zoning on their property located on Hwy 15, Block E, Unit 2, Gold Creek Subdivision, in the City of Dacula. The property was previously zoned R-3 to R-2. Public hearing was held on September 10, 2007. Tabled until November 14, 2007.

On November 14, 2007, the public hearing was held at the Fire Station. The property is located on Hwy 15, Block E, Unit 2, Gold Creek Subdivision. There was no zoning map or other documents available for review. Mr. Mike Riley stated that he recommended the Planning Director to approve conditions on the subject property. Steve Holder read the recommended zoning amendment and motioned to have the same approved. Linda Grant, seconded. Motion carried with the alternative motion, motion by Cox, second by Jonathan Cox.

PUBLIC HEARINGS:

1. Zoning Amendment Petition, ANR-07-054: Gilbert B. Marquita has made application to amend the zoning on Hwy 15, Block E, Unit 2, Gold Creek Subdivision, in the City of Dacula. The subject property is currently zoned RCD in the County and would be PUD in the City. Amendments are requested to change the zoning to R-3 and to change the zoning to R-2. The public hearing was held on October 1, 2007. Tabled until November 14, 2007.

On November 14, 2007, the public hearing was held at the Fire Station. The property is located on Hwy 15, Block E, Unit 2, Gold Creek Subdivision. There was no zoning map or other documents available for discussion. Mr. Mike Riley stated that he recommended the Planning Director to approve conditions on the subject property. Steve Holder read the recommended zoning amendment and motioned to have the same approved. Linda Grant, seconded. Motion carried with the alternative motion, motion by Cox, second by Jonathan Cox.

2. Zoning Adjustment Petition, ANR-07-055: Avery Homes Inc. has made application to amend the zoning on Hwy 15, Block E, Unit 2, Gold Creek Subdivision, in the City of Dacula. The subject property is currently zoned RCD in the County and would be PUD in the City. Amendments are requested to change the zoning to R-3 and to change the zoning to R-2. The public hearing was held on October 1, 2007. Tabled until November 14, 2007.

On November 14, 2007, the public hearing was held at the Fire Station. The property is located on Hwy 15, Block E, Unit 2, Gold Creek Subdivision. There was no zoning map or other documents available for discussion. Mr. Mike Riley stated that he recommended the Planning Director to approve conditions on the subject property. Steve Holder read the recommended zoning amendment and motioned to have the same approved. Linda Grant, seconded. Motion carried with the alternative motion, motion by Cox, second by Jonathan Cox.

3. Zoning Adjustment Petition, ANR-07-056: An amendment accepting and enacting a code for the City of Dacula.

Georgia Code Ordinance: An amendment accepting and enacting a code for the City of Dacula.

Group A, according to the City of Dacula was not included in the petition for the

MINUTES
CITY COUNCIL REGULAR MEETING
OCTOBER 1, 2007
7:00 P.M.

MINUTES
CITY COUNCIL REGULAR MEETING
OCTOBER 1, 2007
7:00 P.M.

Upon receiving the plaque Mayor Cox stated that he truly honored to be presented such a prestigious award. Mayor Cox stated that he knew Phil Landrum personally and that he was a gentleman and one of the greatest compliment to him.

ADJOURNMENT: There being no further business, Mike Stoebe made a motion to adjourn, seconded by Linda Grant. Motion adopted at 7:25 p.m.

John Carter, City Clerk, 10/1/07, 7:25 p.m.

John Carter, City Clerk, 10/1/07, 7:25 p.m.

Councilmember Jonathan Cox

Linda Grant
Councilmember Linda Grant

Mike Seaborn
Councilmember Mike Seaborn

Councilmember Mike Wilson

Kim Comerford, City Clerk

Attest:

John Carter

John Carter, City Clerk

Page 2 of 3

Page 3 of 3

6-21-2023 Revised to add misc. site data

Final Subdivision Plat #6
SILVER LEAF
SUBDIVISIONS

Land lots 446 & 447, 4th District, 1st Section

City of Dawsonville, Dawson County, Georgia

7/1/2022


McWhorter


& Anderson


LAND SURVEYING &
CIVIL ENGINEERING


EXHIBIT "B"
sheet 2




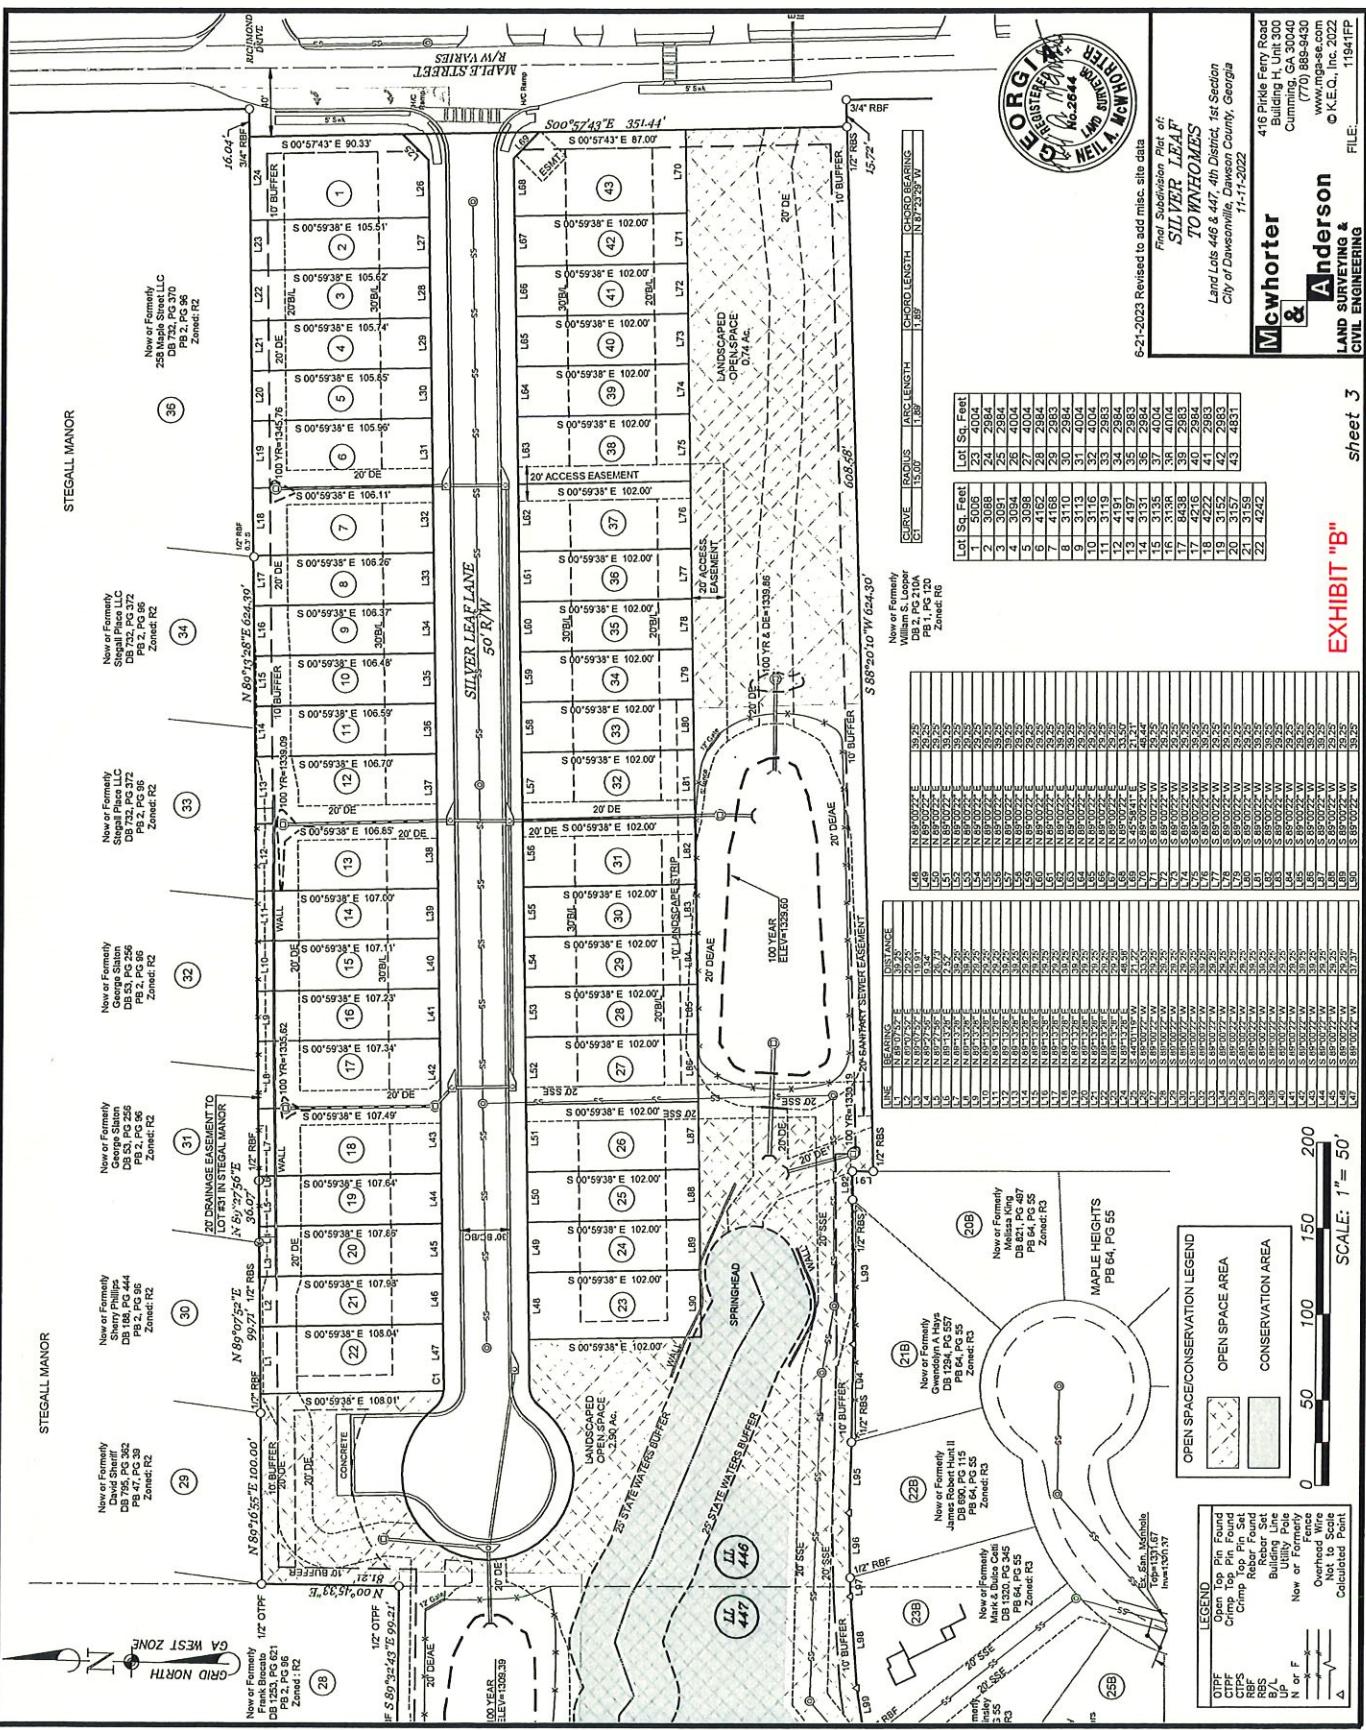


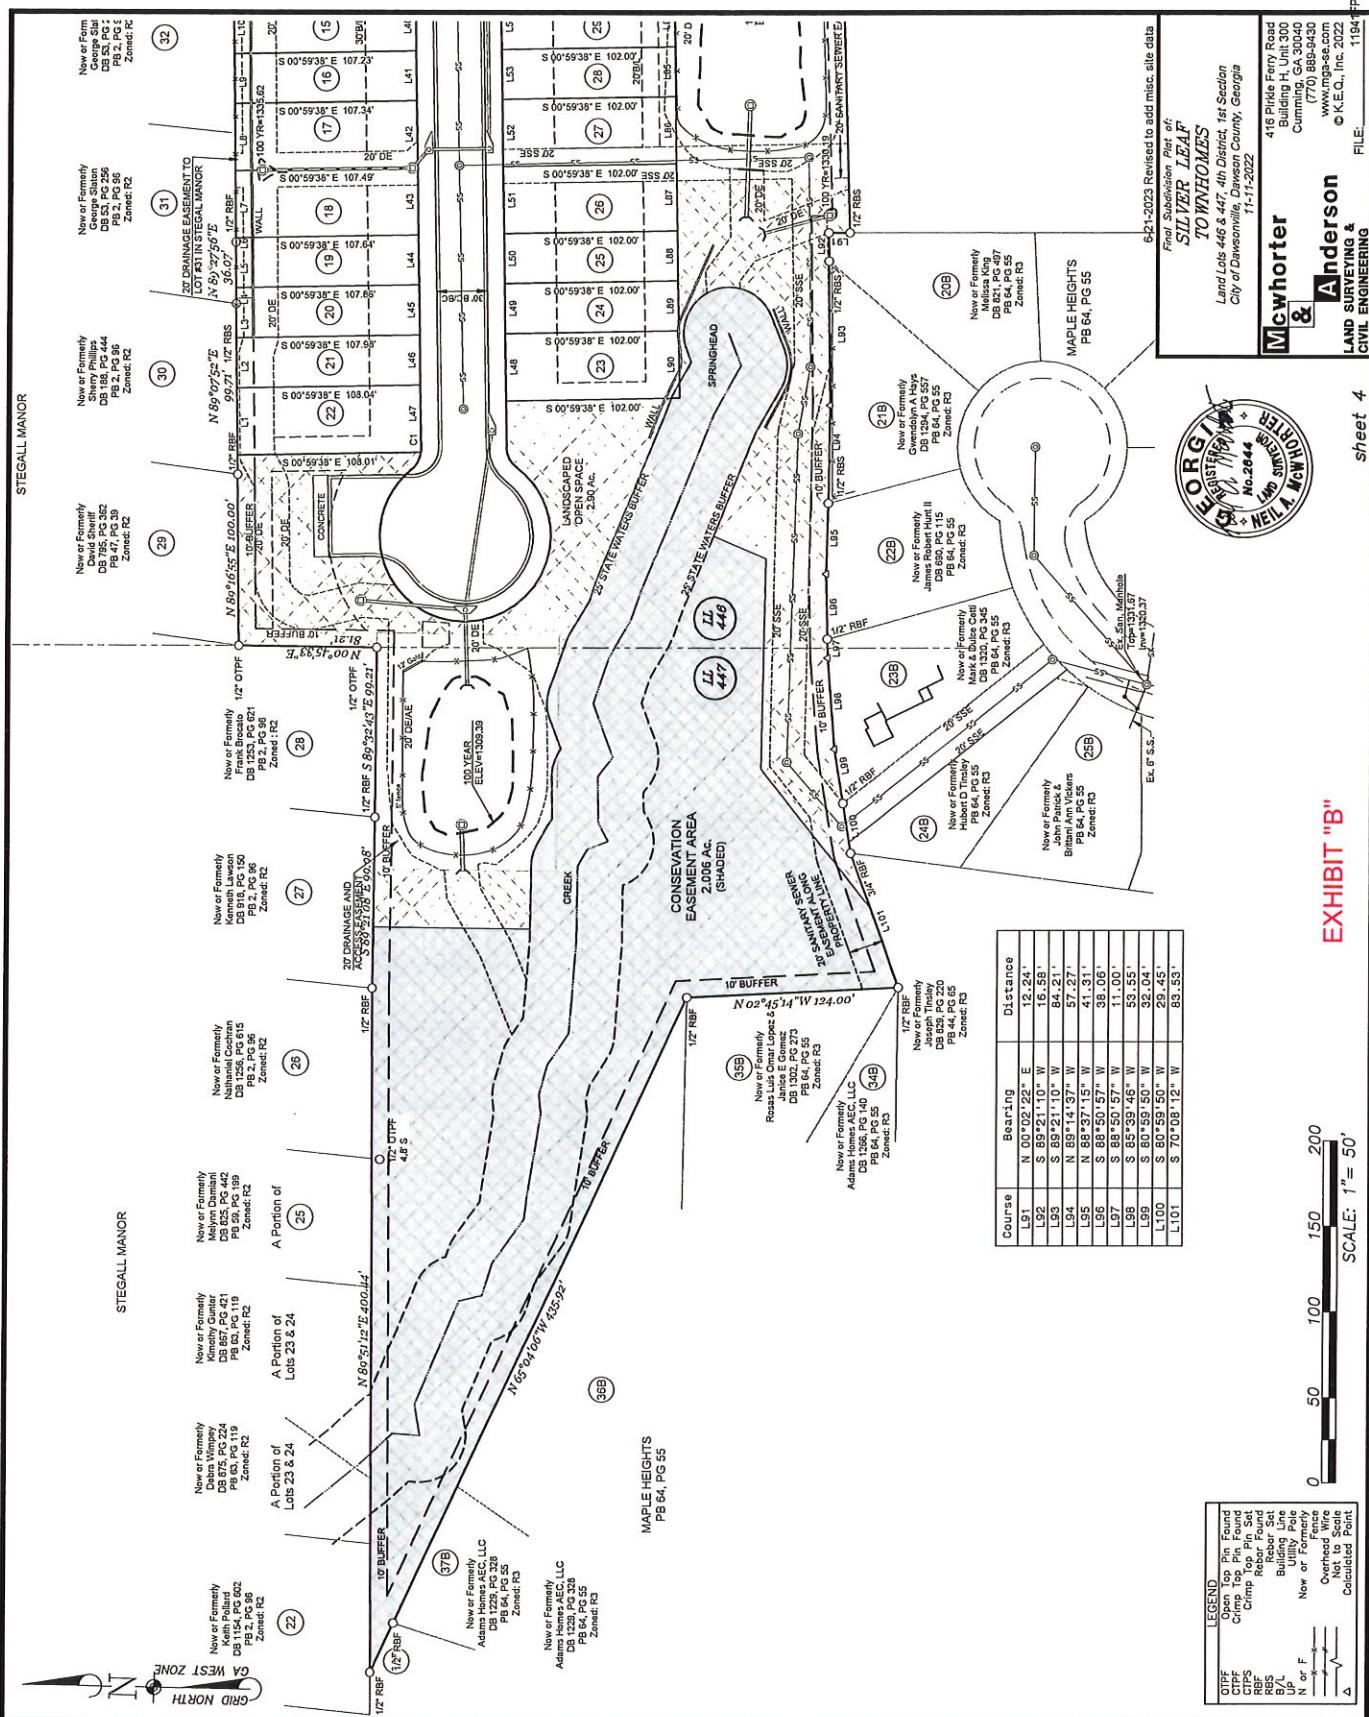

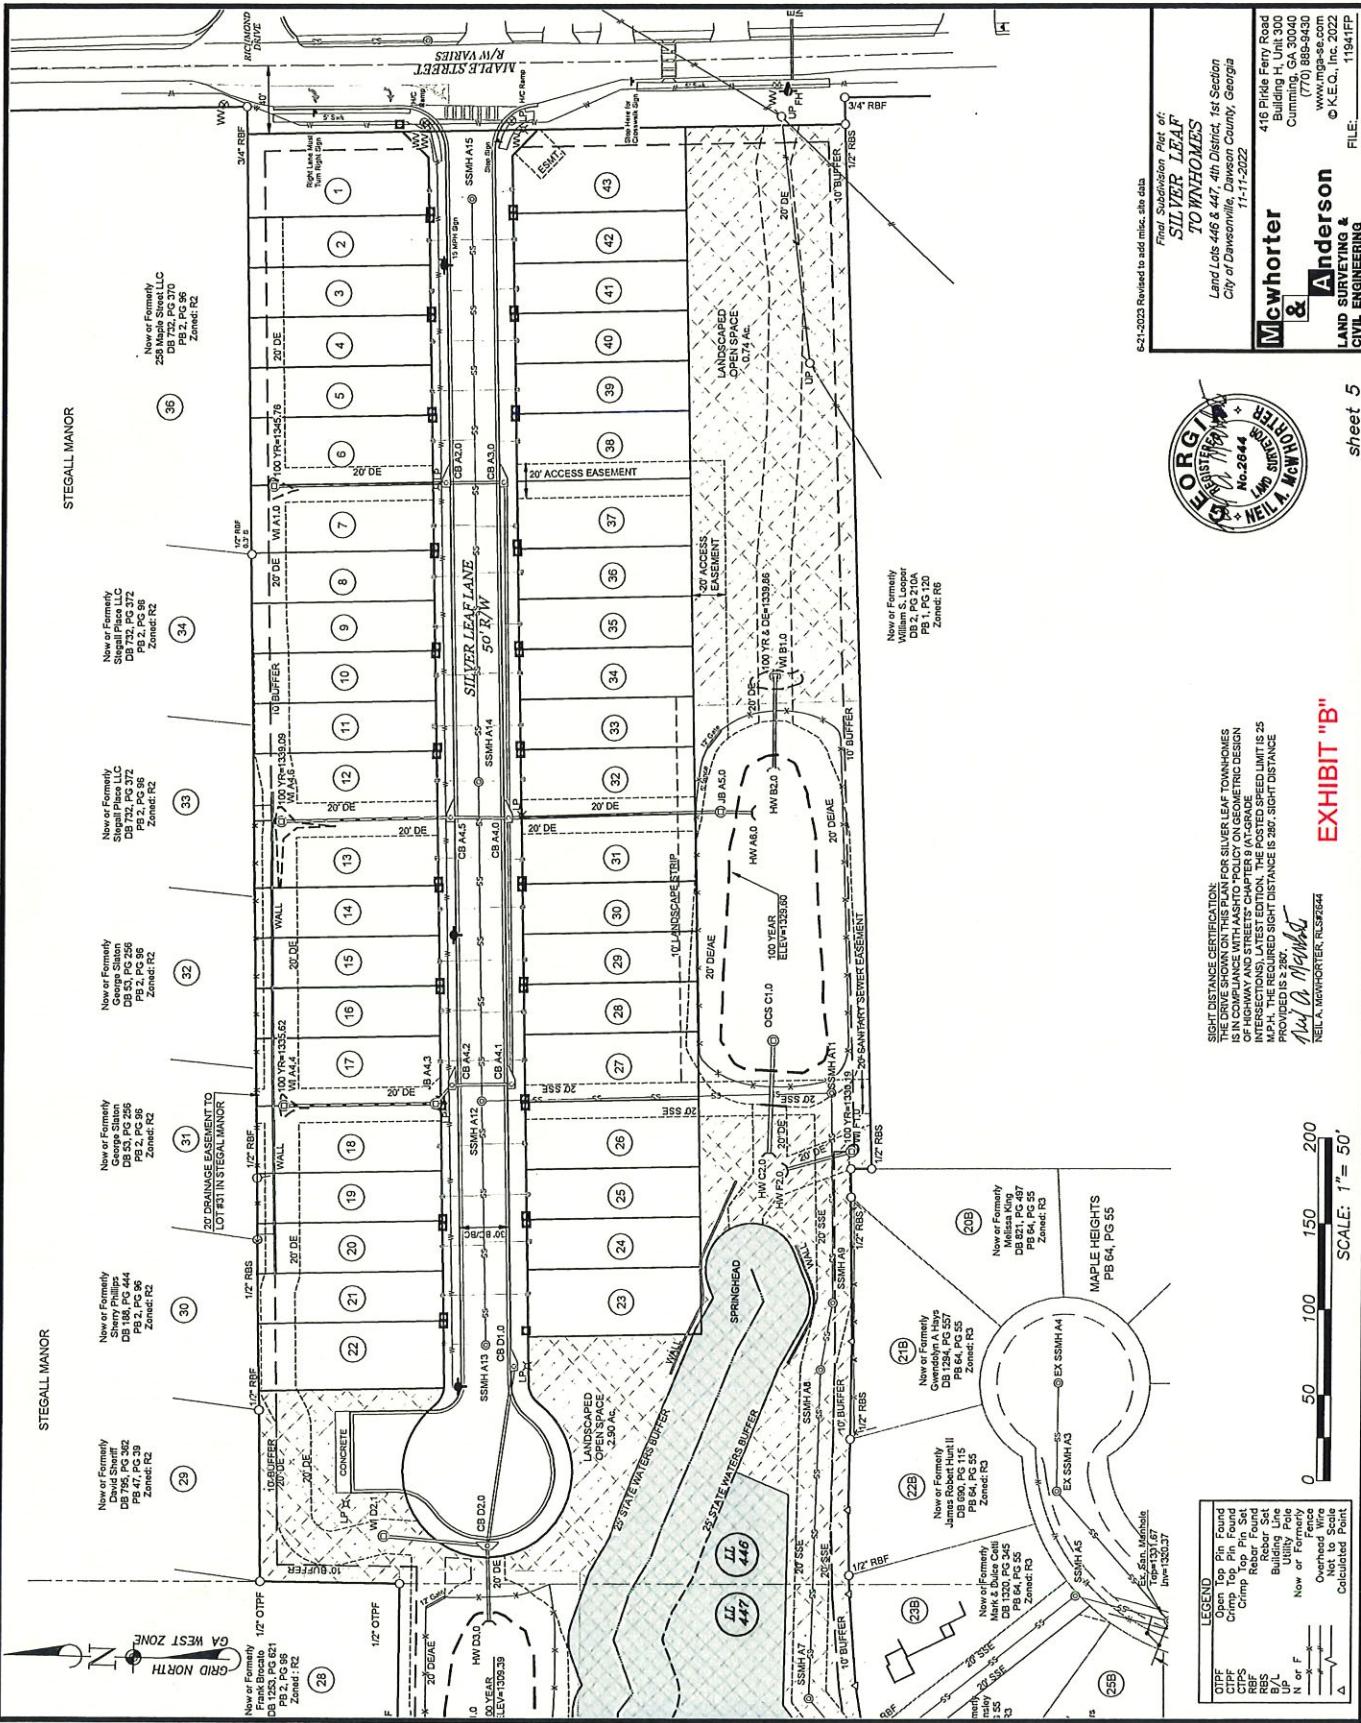


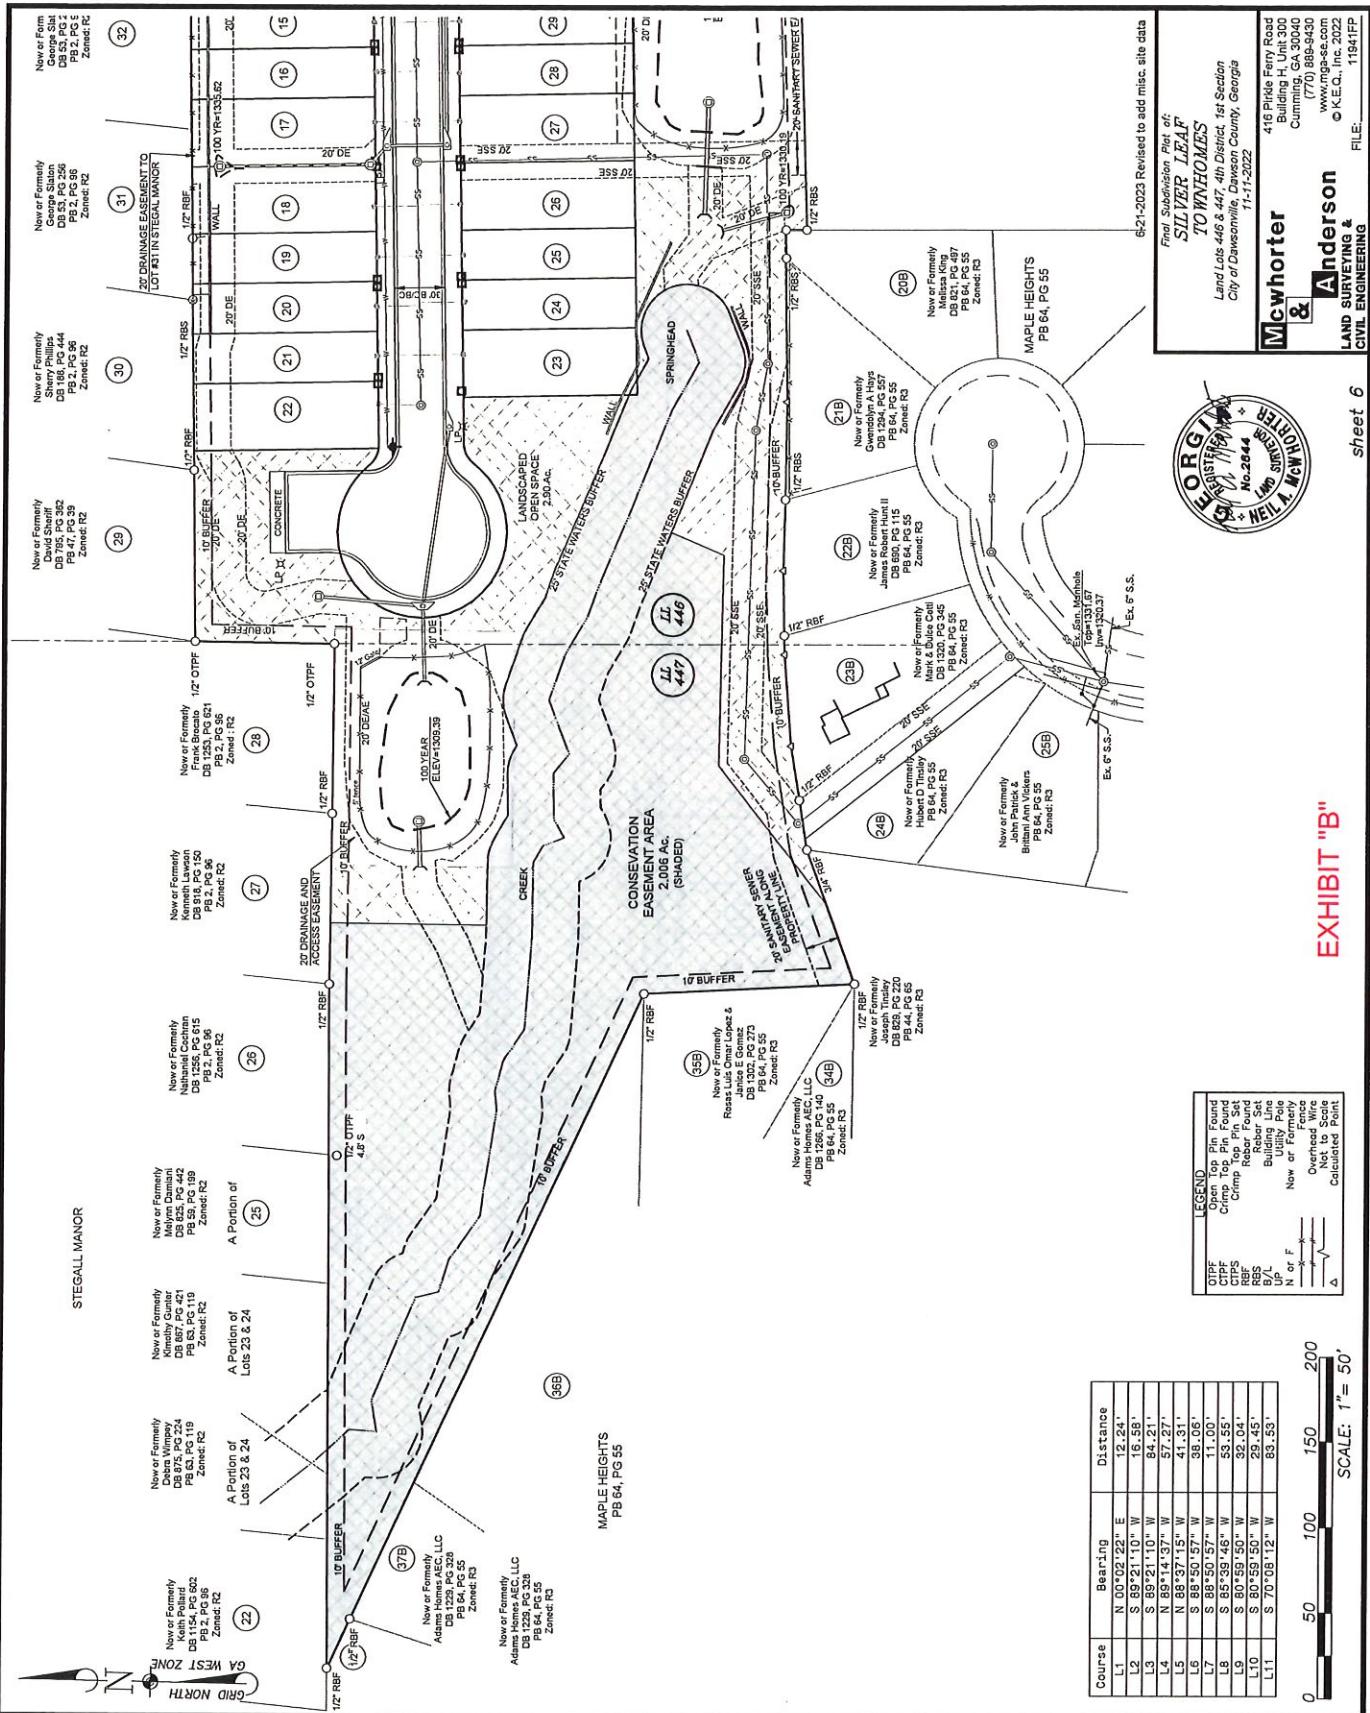


GRID NORTH
GA WEST ZONE

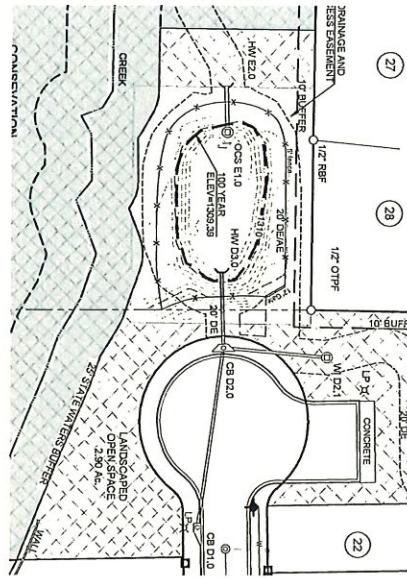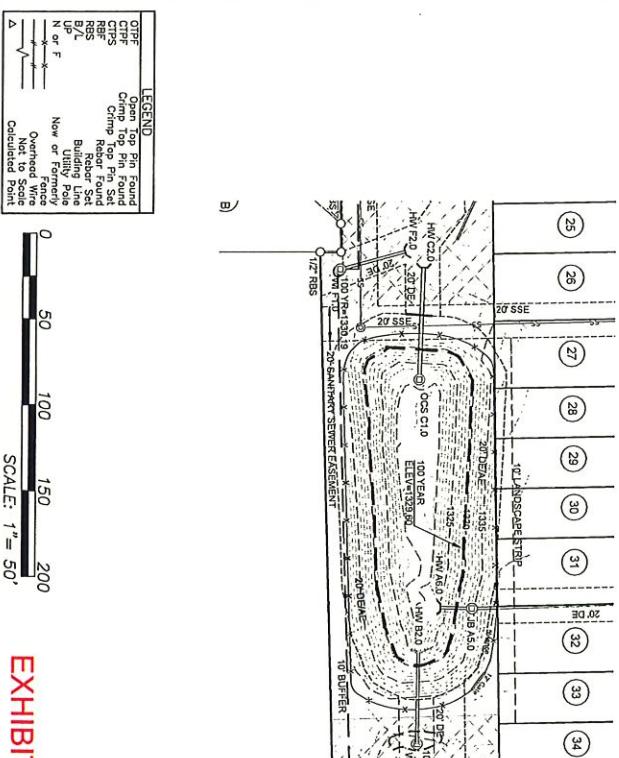

© AS-BUILT OUTLET CONTROL STRUCTURE, ELEV.

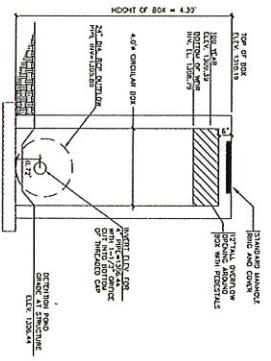

Pond Report
Pond No. 11 - As-Built Plan C
Pond Date: 11-17-2022
Project Name: Dawsonville Creek Subdivision Project Report - 100-Year
Report Status: Draft
Report Type: General Report - Not Incorporated - Test Report
Report Date: 11-17-2022
Report Version: 1
Report Author: K.E.O., Inc.
Report File Number: 11941FP

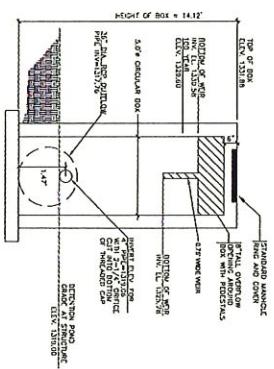

6-21-2023 Revised to add misc. site data

Final Subdivision Plat of
SLIVER LEAF
TO WHOM HOPES
Land Lots 446 & 447, 4th District, 1st Section
City of Dawsonville, Dawson County, Georgia
11-17-2022

McWhorter & **Anderson**

LAND SURVEYING &
CIVIL ENGINEERING

